

Pearl River
A-2002
7/30/76

MISSISSIPPI
BOARD OF WATER COMMISSIONERS
416 North State Street
Jackson, Mississippi 39201

WATER WELL DRILLERS LOG

7-30 1976 Bud Lester Pearl River
date well completed firm name county well located

LANDOWNER: Virginia Beum
Boylanville, Mo.

description of formations encountered	from	to
	<u>Red shale</u>	<u>0</u>
<u>white sand</u>	<u>30</u>	<u>85</u>

questing on location
(mailing address)

WELL LOCATION:
T 20 N 18 E
R 12 S
0 12 miles North of Cross Roads
(distance) (direction) (nearest town)

WELL PURPOSE: Home
(home, irrigation, municipal, industrial)

WELL COMPLETION DATA:

- (1) diameter (inches) 4 1/2
- (2) total depth (feet) 85
- (3) static water level (feet) 60 below above top of ground.
- (4) casing PVC 1 1/2
(material) (depth)

(size) if telescope see back.

- (5) screen 4x10 7 1/2
(length) (depth to top)

(size) (material)

- (6) pump 1/2 650 M
(HP) (yield gpm)

electric
(type power)

- (7) electric log no
(yes or no)

(organization running log)


- (8) how well bottom plugged Sand Shank

DRILLERS REMARKS:

RECEIVED
SEP - 2 1976

If well telescopes please
sketch and show depths.

GROUND LEVEL

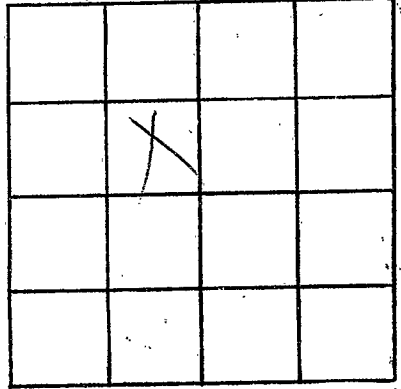

SECTION _____

Please indicate well location X.

ADDITIONAL INFORMATION

If more than one screen,
show locations of each on sketch.