

Pearl River
A 2003
2/18/77

MISSISSIPPI
 BOARD OF WATER COMMISSIONERS
 416 North State Street
 Jackson, Mississippi 39201

WATER WELL DRILLERS LOG

2/18 1977 Hollinger Well Pearl River
 date well completed firm name county well located


LANDOWNER:	description of formations encountered	from	to
<u>G. S. Moody</u>			
<u>Box 14</u>			
<u>Poplarville, Miss</u> (mailing address)	<u>CLAY</u>	<u>0</u>	<u>40</u>
	<u>SAND</u>	<u>40</u>	<u>80</u>
	<u>GRAVEL</u>	<u>80</u>	<u>120</u>
WELL LOCATION:			
sec. <u>15</u> T. <u>1</u> N. R. <u>17</u> E.			
<u>3</u> miles <u>N</u> of <u>Ford Creek</u>			
(distance) (direction) (nearest town)			
WELL PURPOSE: <u>Home</u> (home, irrigation, municipal, industrial)			
WELL COMPLETION DATA:			
(1) diameter (inches)	<u>2</u> "		
(2) total depth (feet)	<u>120</u>		
(3) static water level (feet)	<u>40</u> <u>below</u> top of ground.		
(4) casing	<u>PVC</u> (material)		
	(depth)		
	(size) if telescope see back.		
(5) screen	<u>5</u> (length)	<u>115</u> (depth to top)	
	(size)	<u>PVC</u> (material)	
(6) pump	<u>1</u> (HP)	<u>7</u> (yield gpm)	
	<u>elect</u> (type power)		
(7) electric log	(yes or no)		
	(organization running log)		
(8) how well bottom plugged	<u>sand</u> <u>SPARK</u>		
DRILLERS REMARKS: <u>Very good!</u>			

RECEIVED
 MAR - 7 1977

MISS. BD. OF WATER COMMISSIONERS

If well telescopes please sketch and show depths.

GROUND LEVEL

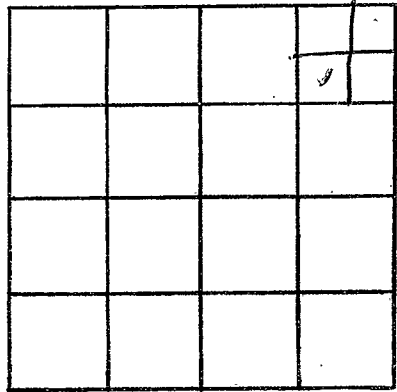

SECTION 15

Please indicate well location X.

ADDITIONAL INFORMATION

If more than one screen,
show locations of each on sketch.