

Pearl River
A 2004
5-10-77

MISSISSIPPI
BOARD OF WATER COMMISSIONERS
416 North State Street
Jackson, Mississippi 39201

WATER WELL DRILLERS LOG

5/10/77 1977 Hollinger Pump Well Pearl River County
date well completed firm name county well located

LANDOWNER: Samuel Abram
RT 1 Box 95
Poplarville Miss
(mailing address)

description of formations encountered	from	to
	sandy clay	0
sandy chalk	70	150
Chalk	150	200
sand	200	240

WELL LOCATION:
sec. 15 T 1 N R 17 E
3 miles N of Ford Creek
(distance) (direction) (nearest town)

WELL PURPOSE: Home
(home, irrigation, municipal, industrial)

WELL COMPLETION DATA:

(1) diameter (inches) 2"
(2) total depth (feet) 240
(3) static water level (feet) 115 below top of ground.
(4) casing PVC, 230 (material) (depth)
(size) If telescope see back.
(5) screen 10 (length), 230 (depth to top)
2" (size), PVC (material)
(6) pump 1 1/2 (HP), 5 (yield gpm)
elect (type power)
(7) electric log (yes or no)
(organization running log)
(8) how well bottom plugged sand & chalk


DRILLERS REMARKS: Fair well

RECEIVED
JUN 15 1977

MISS. BU. OF WATER COMM.

If well telescopes please sketch and show depths.

GROUND LEVEL

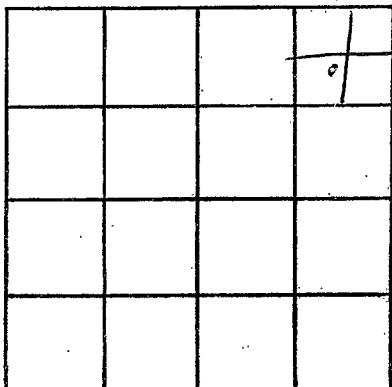

SECTION 15

Please indicate well location X.

ADDITIONAL INFORMATION

If more than one screen, show locations of each on sketch.