

Pearl River
A 2005
7/11/77

MISSISSIPPI
BOARD OF WATER COMMISSIONERS
416 North State Street
Jackson, Mississippi 39201

13V

WATER WELL DRILLERS LOG


7/11/77 date well completed 1977 Hollinger Well firm name Pearl River county well located

LANDOWNER: <u>Clarence Rawls</u>	description of formations encountered	from	to
<u>Populawille, Miss</u> (mailing address)			
WELL LOCATION:			
sec. <u>13</u> T. <u>1</u> N. R. <u>16</u> E. S. <u>17</u> W.			
<u>1 1/2</u> miles (distance) <u>E</u> (direction) of <u>Ford Creek</u> (nearest town)			
WELL PURPOSE: <u>Home</u> (home, irrigation, municipal, industrial)			
WELL COMPLETION DATA:			
(1) diameter (inches) <u>2"</u>			
(2) total depth (feet) <u>80</u>			
(3) static water level (feet) <u>50</u> <u>below</u> top of ground. <u>above</u>			
(4) casing <u>PVC</u> <u>75'</u> (material) (depth)			
(size) if telescope see back.			
(5) screen <u>5'</u> <u>75'</u> (length) (depth to top)			
<u>2</u> <u>PVC</u> (size) (material)			
(6) pump <u>1</u> <u>7</u> (HP) (yield gpm)			
<u>elect</u> (type power)			
(7) electric log <u> </u> (yes or no)			
(organization running log)			
(8) how well bottom plugged <u>sand</u> <u>SHARK</u>			
DRILLERS REMARKS: <u>good</u> <u>well</u>			

RECEIVED
SEP 19 1977

If well telescopes please sketch and show depths.

GROUND LEVEL

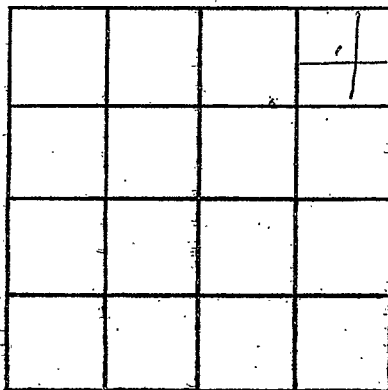

SECTION 13

Please indicate well location X.

ADDITIONAL INFORMATION

If more than one screen,
show locations of each on sketch.