

PEAR RIVER  
A  
2006

MISSISSIPPI  
BOARD OF WATER COMMISSIONERS  
416 North State Street  
Jackson, Mississippi 39201

WATER WELL DRILLERS LOG

11-11-1978 Stockfield Bros. Inc. Pearl River  
date well completed firm name county well located

LANDOWNER: Ted H. Kampen  
1300 Nursery Ave -  
Metairie, La - 70005  
(mailing address)

description of formations encountered	from	to
Clay	0	30
Sand	30	105

WELL LOCATION:  
sec. 35 T 1 N R 17 E  
2 1/2 miles S E of Fonda, La  
(distance) (direction) (nearest town)

WELL PURPOSE: Home  
(home, irrigation, municipal, industrial)

- WELL COMPLETION DATA:
- (1) diameter (inches) 4"
  - (2) total depth (feet) 105 ft
  - (3) static water level (feet) 85 <sup>below</sup> above top of ground.
  - (4) casing PVC  
(material) (depth)  
(size) if telescope see back.
  - (5) screen 6 99  
(length) (depth to top)  
(size) (material)
  - (6) pump 1 1/2 325 gpm  
(HP) (yield gpm)
  - (type power)
  - (7) electric log yes or no  
(organization running log)
  - (8) how well bottom plugged Sand Shrub


RECEIVED  
MAY 24 1978

MISS. BD. OF WATER COMM.

DRILLERS REMARKS:

If well telescopes please sketch and show depths.

GROUND LEVEL

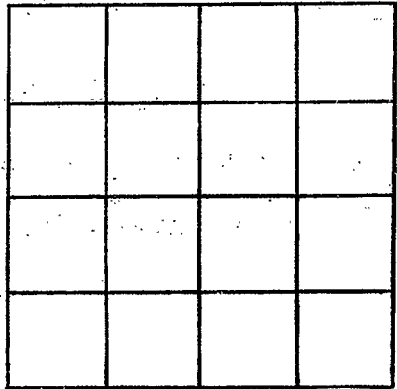

SECTION \_\_\_\_\_

Please indicate well location X.

ADDITIONAL INFORMATION

If more than one screen, show locations of each on sketch.