

PEAR RIVER
A
2000

**MISSISSIPPI
BOARD OF WATER COMMISSIONERS**
416 North State Street
Jackson, Mississippi 39201

WATER WELL DRILLERS LOG

12-3 1978 Steelwell Bros. Inc. Pearl River
 date well completed firm name county well located

LANDOWNER:
J. V. Genzales
Fords Ch. Road.
Ospreyville, Miss. 39470
 (mailing address)

description of formations encountered	from to	
	feet	feet
Clay	0	30
Sand	30	195

WELL LOCATION:
 sec. 35 T 1 N R 17 E
3 miles SE of Fords Ch.
 (distance) (direction) (nearest town)

WELL PURPOSE: Home
 (home, irrigation, municipal, industrial)

- WELL COMPLETION DATA:**
- (1) diameter (inches) 4"
 - (2) total depth (feet) 135 ft.
 - (3) static water level (feet) 100' ^{below} _{above} top of ground.
 - (4) casing P.V.C., 129'
 (material) (depth)
4" if telescope see back.
 (size)
 - (5) screen 6', 129'
 (length) (depth to top)
4", P.V.C.
 (size) (material)
 - (6) pump 1/2, 325 GPM
 (HP) (yield gpm)
Elec.
 (type power)
 - (7) electric log No
 (yes or no)

(organization running log) _____
 (8) how well bottom plugged Sand
Shark


DRILLERS REMARKS:

RECEIVED
 MAY 24 1978

MISSISSIPPI WATER COMMISSION

If well telescopes please sketch and show depths.

GROUND LEVEL

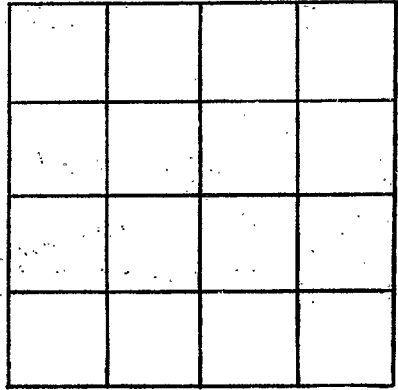

SECTION _____

Please indicate well location X.

ADDITIONAL INFORMATION

If more than one screen, show locations of each on sketch.