

PEARL RIVER

A 2008

3-29-79

MISSISSIPPI BOARD OF WATER COMMISSIONERS
416 North State Street
Jackson, Mississippi 39201

WATER WELL DRILLERS LOG

3/29 1979
date well completed

Hollinger
firm name

Pearl River
county well located

LANDOWNER: C Ameles Stimpore

RT-1

Poplarville, MS
(mailing address)

description of formations encountered

from to

Clay, gravel 0 60
sand, gravel 60 107

WELL LOCATION:

sec. 16 T. 1 N R. 17 E
1/4 miles N of Ford Creek
(distance) (direction) (nearest town)

WELL PURPOSE:

(home, irrigation, municipal, industrial)

WELL COMPLETION DATA:

- (1) diameter (inches) 4"
- (2) total depth (feet) 107
- (3) static water level (feet) 80 below above top of ground.
- (4) casing pvc, 100 (material) (depth)
(size) If telescope see back.
- (5) screen 7, 100 (length) (depth to top)
4, pvc (size) (material)
- (6) pump 3/4, 12 (HP) (yield gpm)
elect (type power)
- (7) electric log (yes or no)

(organization running log)

(8) how well bottom plugged sand SHARK

DRILLERS REMARKS: good well


Miss. Board of Water Comm.

MAY 14 1979

RECEIVED

If well telescopes please sketch and show depths.

GROUND LEVEL

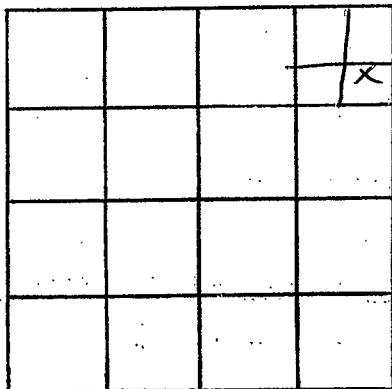

SECTION 16

Please indicate well location X.

ADDITIONAL INFORMATION

If more than one screen, show locations of each on sketch.