

Pearl River
 A 2010
 3-27-79

MISSISSIPPI
 BOARD OF WATER COMMISSIONERS
 416 North State Street
 Jackson, Mississippi 39201

WATER WELL DRILLERS LOG

3/27 1979 Hollinger Pearl River
 date well completed firm name county well located

LANDOWNER: <u>Quitman Lewis</u> <u>Rt 1</u>	description of formations encountered	from	to
<u>Poplarville MS</u> (mailing address)	<u>sand, CHALK,</u> <u>gravel, sand</u>	<u>0</u> <u>200</u>	<u>200</u> <u>260</u>
WELL LOCATION:			
sec. <u>4</u> T <u>1</u> N R. <u>17</u> E <u>S</u> <u>W</u> <u>6</u> miles <u>N</u> of <u>Ford Creek</u> (distance) (direction) (nearest town)			
WELL PURPOSE: (home, irrigation, municipal, industrial)			
WELL COMPLETION DATA:			
(1) diameter (inches) <u>4</u>			
(2) total depth (feet) <u>260</u>			
(3) static water level (feet) <u>136</u> ^{below} above top of ground.			
(4) casing <u>PVC</u> , <u>250</u> (material) (depth) (size) if telescope see back.			
(5) screen <u>10</u> , <u>250</u> (length) (depth to top)			
(6) pump <u>4</u> , <u>PVC</u> (size) (material)			
(6) pump <u>1/2</u> , <u>8</u> (HP) (yield gpm)			
<u>elect.</u> (type power)			
(7) electric log _____ (yes or no)			
_____ (organization running log)			
(8) how well bottom plugged <u>sand</u> <u>SHARK</u>			
DRILLERS REMARKS: <u>good well</u>			


Miss. Board of Water Comm.

MAY 14 1979

RECEIVED

If well telescopes please sketch and show depths.

GROUND LEVEL

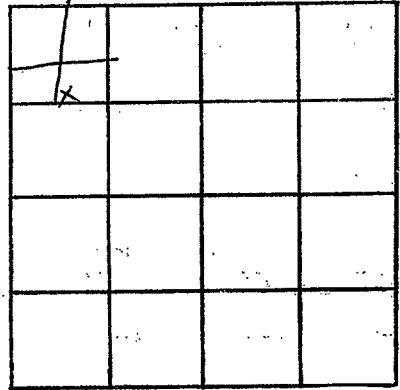

SECTION 4

Please indicate well location X.

ADDITIONAL INFORMATION

If more than one screen, show locations of each on sketch.