

Pearl River
A 2012
9-22-80

MISSISSIPPI
 BOARD OF WATER COMMISSIONERS
 416 North State Street
 Jackson, Mississippi 39201

WATER WELL DRILLERS LOG

9/22 1980 Red Penton Water Pearl River
 date well completed Well Service firm name county well located

LANDOWNER: Dore Platts
Rt. 1 Box 96 Poplarville
Miss
 (mailing address)

description of formations encountered	from	to
<u>Red shale</u>	<u>0</u>	<u>18</u>
<u>Red sand</u>	<u>18</u>	<u>32</u>
<u>White shale</u>	<u>32</u>	<u>220</u>
<u>White sand</u>	<u>220</u>	<u>320</u>

WELL LOCATION:
 sec. 16 T 1 N R 17 E
16 miles North Pearl River
 (distance) (direction) (nearest town)

WELL PURPOSE: home
 (home, irrigation, municipal, industrial)

- WELL COMPLETION DATA:
- (1) diameter (inches) 2"
 - (2) total depth (feet) 320
 - (3) static water level (feet) 135 below top of ground.
 - (4) casing pvc 310
 (material) (depth)
 (size) if telescope see back.
 - (5) screen 10 310
 (length) (depth to top)
12 pvc
 (size) (material)
 - (6) pump 2 1/2 280 m
 (HP) (yield gpm)
Elect
 (type power)
 - (7) electric log no
 (yes or no)

(organization running log)
 (8) how well bottom plugged Shank

DRILLERS REMARKS:


DEPT. OF NATURAL RESOURCES
 BUREAU OF LAND & WATER RESOURCES

OCT - 8 1980

RECEIVED

If well telescopes please sketch and show depths.

GROUND LEVEL

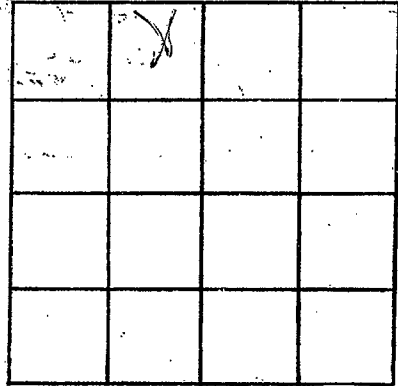

SECTION _____

Please indicate well location X.

ADDITIONAL INFORMATION

Lined area for additional information.

If more than one screen, show locations of each on sketch.