

MISSISSIPPI DEPARTMENT OF NATURAL RESOURCES

Bureau of Land and Water Resources

Southport Mall

P.O. Box 10631

Jackson, Mississippi 39209

WATER WELL & DRILLERS LOG

WATER WELL SERVICE

ROUTE 3 BOX 41

CARRIERS, MO 63420

PHONE 798-5324

Pearl River

county well located

Pearl River
A 2014
6-18-81

6-18 19 81
 date well completed

LANDOWNER: Eddie Mozze
Poplarville Ms.

description of formations encountered

from to

(mailing address)

WELL LOCATION:
 sec. 34 T. 2 N. R. 17 E.
8 miles NW of Poplarville
 (distance) (direction) (nearest town)

gray shale 0 30
Blue shale 30 45
sand 45 180
 100 190

WELL PURPOSE: Home
 (home, irrigation, municipal, industrial)

WELL COMPLETION DATA:

- (1) diameter (inches) 2
- (2) total depth (feet) 190
- (3) static water level (feet) 90 below above top of ground.
- (4) casing Pvc 180
 (material) (depth)

_____ If telescope see back.
 (size)

- (5) screen 10 180
 (length) (depth to top)
- 2 PVC
 (size) (material)

- (6) pump 1 400
 (HP) (yield gpm)
- elec
 (type power)

- (7) electric log _____
 (yes or no)

_____ (organization running log)

- (8) how well bottom plugged and
slab

DRILLERS REMARKS:


DEPT. OF NATURAL RESOURCES
 BUREAU OF LAND & WATER RESOURCES

NOV 9 - 1981

RECEIVED

If well telescopes please sketch and show depths.

GROUND LEVEL

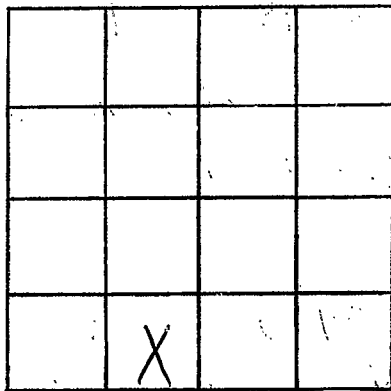

SECTION _____

Please indicate well location X.

ADDITIONAL INFORMATION

If more than one screen,
show locations of each on sketch.