

MISSISSIPPI DEPARTMENT OF NATURAL RESOURCES

Bureau of Land and Water Resources

Southport Mall

P.O. Box 10631

Jackson, Mississippi 39209

WATER WELL DRILLERS LOG

Pearl River
A 2019
6-20-81

date well completed 6/20/81 ~~Clear Water Authority~~ Pearl River
 signature Robert L. Schmit county well located

LANDOWNER: Hinds
P.O. Box 382
Belle Chasse, La. 70037
 (mailing address)

WELL LOCATION:
 sec 10 T 1 N R 17 E
9 miles (distance) NW (direction) of Bayou La Batre (nearest town)

WELL PURPOSE: home
 (home, irrigation, municipal, industrial)

- WELL COMPLETION DATA:
- (1) diameter (inches) 4"
 - (2) total depth (feet) 120
 - (3) static water level (feet) 81' below top of ground.
 - (4) casing PVC 120
 (material) (depth)
4" if telescope see back.
 (size)
 - (5) screen 20' 100'
 (length) (depth to top)
4" PVC-012
 (size) (material)
 - (6) pump 1 20 GPM
 (HP) (yield gpm)
220. AC
 (type power)
 - (7) electric log _____
 (yes or no)

 (organization running log)
 - (8) how well bottom plugged BW 1/2 in.


description of formations encountered	from	to
top soil	6"	4"
red clay	4"	35'
red clay small gravel	35'	45'
yellow clay red sand	45'	50'
yellow clay coarse gravel	50'	70'
coarse tan sand	70'	90'
coarse tan sand small gravel	90'	120'



DRILLERS REMARKS:

If well telescopes please sketch and show depths.

GROUND LEVEL

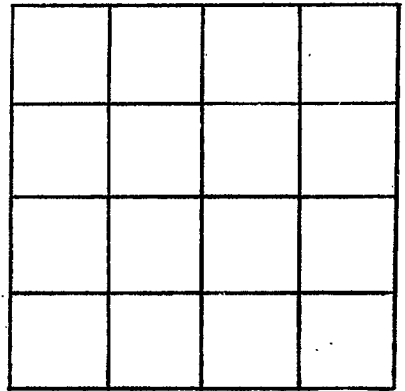

SECTION _____

Please indicate well location X.

ADDITIONAL INFORMATION

If more than one screen,
show locations of each on sketch.