

MISSISSIPPI DEPARTMENT OF NATURAL RESOURCES

Bureau of Land and Water Resources

Southport Mall

P.O. Box 10631

Jackson, Mississippi 39209

WATER WELL DRILLERS LOG

*Paul River*  
A  
2014

July 12, 1982 date well completed  
Wallace Wellboring firm name  
Paul River county well located

LANDOWNER: <i>Ray and</i>	description of formations encountered	from	to
<i>poplar hill</i>			
<i>Ford Creek</i> (mailing address)	<i>Red sand</i>	<i>0</i>	<i>36</i>
WELL LOCATION:	<i>Red shale</i>	<i>36</i>	<i>90</i>
sec. <i>8</i> T. <i>1</i> R. <i>17</i>	<i>fine sand</i>	<i>90</i>	<i>120</i>
<i>20</i> miles <i>N</i> of <i>443</i>	<i>blue shale</i>	<i>120</i>	<i>170</i>
(distance) (direction) (nearest town)	<i>Gravel</i>	<i>170</i>	<i>235</i>
WELL PURPOSE: <i>home</i>			
(home, irrigation, municipal, industrial)			
WELL COMPLETION DATA:			
(1) diameter (inches) <i>4"</i>			
(2) total depth (feet) <i>235</i>			
(3) static water level (feet) <i>159</i> below top of ground.			
(4) casing <i>PVC</i> , <i>225</i> (material) (depth)			
(size) If telescope see back.			
(5) screen <i>10"</i> , <i>225"</i> (length) (depth to top)			
<i>12</i> , <i>PVC</i> (size) (material)			
(6) pump <i>1</i> , <i>10</i> (HP) (yield gpm)			
<i>elec</i> (type power)			
(7) electric log (yes or no)			
(organization running log)			
(8) how well bottom plugged <i>Sand</i>			
<i>shrub</i>			
DRILLERS REMARKS:			


DEPT. OF NATURAL RESOURCES  
BUREAU OF LAND & WATER RESOURCES

JUL 20 1982

RECEIVED

If well telescopes please sketch and show depths.

GROUND LEVEL

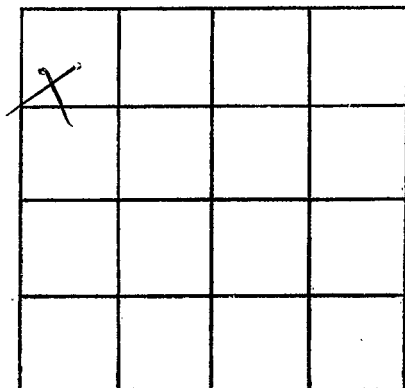

SECTION \_\_\_\_\_

Please indicate well location X.

ADDITIONAL INFORMATION

If more than one screen, show locations of each on sketch.