

MISSISSIPPI DEPARTMENT OF NATURAL RESOURCES

Bureau of Land and Water Resources

Southport Mall

P.O. Box 10631

Jackson, Mississippi 39209

WATER WELL DRILLERS LOG

Seal River  
A  
2018

5-1-1982 date well completed      Hollinger firm name      Pearl River Co. county well located

LANDOWNER: <u>R. J. Haynes</u>	description of formations encountered	from	to
<u>Rt.</u>			
<u>Prentiss, ms.</u> (mailing address)	<u>sand, gravel</u>	<u>0</u>	<u>100</u>
	<u>sand, gravel, clay</u>	<u>100</u>	<u>200</u>
	<u>coarse sand</u>	<u>200</u>	<u>240</u>
<b>WELL LOCATION:</b>			
sec. <u>7</u> T <u>1</u> <u>N</u> R <u>17</u> <u>E</u>			
<u>5</u> miles <u>N</u> of <u>Ford Creek</u>			
(distance) (direction) (nearest town)			
<b>WELL PURPOSE:</b> (home, irrigation, municipal, industrial)			
<b>WELL COMPLETION DATA:</b>			
(1) diameter (inches) <u>2</u>			
(2) total depth (feet) <u>240</u>			
(3) static water level (feet) <u>150</u> <u>below</u> top of ground.			
(4) casing <u>PVC</u> , <u>230</u> , (material) (depth)	<u>copy</u>		
_____ if telescope see back. (size)			
(5) screen <u>10</u> , <u>230</u> (length) (depth to top)			
<u>2</u> , <u>PVC</u> (size) (material)			
(6) pump <u>2</u> <u>6</u> (HP) (yield gpm)			
<u>elect.</u> (type power)			
(7) electric log _____ (yes or no)			
_____ (organization running log)			
(8) how well bottom plugged _____			
<b>DRILLERS REMARKS:</b>			


DEPT. OF NATURAL RESOURCES  
BUREAU OF LAND & WATER RESOURCES

NOV 17 1982

RECEIVED

If well telescopes please sketch and show depths.

GROUND LEVEL

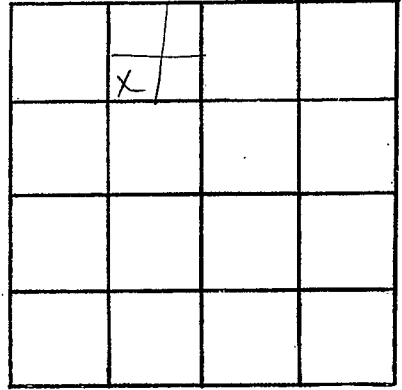

SECTION 7

Please indicate well location X.

ADDITIONAL INFORMATION

If more than one screen, show locations of each on sketch.