

MISSISSIPPI DEPARTMENT OF NATURAL RESOURCES

Bureau of Land and Water Resources

Southport Mall

P.O. Box 10631

Jackson, Mississippi 39209

WATER WELL DRILLERS LOG

PEARL RIVER
A 2000

5-24 1985 WALKERS WELDING BR.
date well completed firm name county well located

LANDOWNER: HAROLD BUTTS
RT. 2
POPLARVILLE MS
(mailing address)

description of formations encountered	from	to
CLAY	0	18
SAND	18	23
CLAY	23	92
SAND	92	96
CLAY	96	117
SAND	117	148

WELL LOCATION:
sec. 36 T. 4 S. R. 17 E. W.
10 miles NW of Poplarville
(distance) (direction) (nearest town)

WELL PURPOSE: HOME
(home, irrigation, municipal, industrial)

- WELL COMPLETION DATA:
- (1) diameter (inches) 4
 - (2) total depth (feet) 148
 - (3) static water level (feet) 108 below top of ground.
 - (4) casing PVC, 148 (material) (depth)
4 (size) if telescope see back.
 - (5) screen 10, 138 (length) (depth to top)
4", PVC (size) (material)
 - (6) pump 1/2 (HP) 8 (yield gpm)
ELEC. (type power)
 - (7) electric log (yes or no)
(organization, running log)
 - (8) how well bottom plugged Sandshook


RECEIVED
JUN 25 1985

Department of Natural Resources
Bureau of Land & Water Resources

DRILLERS REMARKS:

If well telescopes please sketch and show depths.

GROUND LEVEL

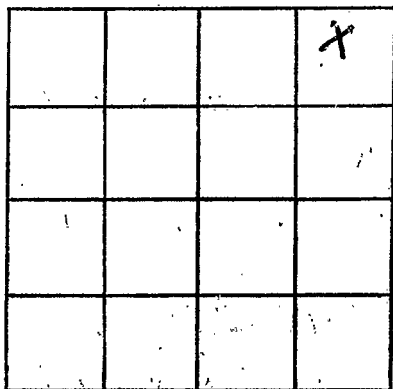

SECTION A

Please indicate well location X.

ADDITIONAL INFORMATION

If more than one screen,
show locations of each on sketch.