

MISSISSIPPI DEPARTMENT OF NATURAL RESOURCES

Bureau of Land and Water Resources

Southport Mall

P.O. Box 10631

Jackson, Mississippi 39209  
**BUD PANTON & SONS**  
**WATER WELL DRILLERS LOG**  
 Water Well Service

Rt. 4, Box 402

Carriere, Mississippi 39426

Phone 601 - 798-5324

PEARL RIVER  
A 202A

2/26  
 date well completed

19 86 M

Carriere, Mississippi 39426

Pearl River  
 county well located

LANDOWNER: Mark Therist

description of formations encountered

from to

R.T. 1 Box 69 K  
Poppville miss.  
 (mailing address)

<u>Red shale</u>	<u>0</u>	<u>26</u>
<u>Red sand</u>	<u>26</u>	<u>35</u>
<u>white shale</u>	<u>35</u>	<u>175</u>
<u>white sand</u>	<u>175</u>	<u>190</u>

WELL LOCATION:

sec 26 T 1 N R 17 E  
14 miles W of Poppville  
 (distance) (direction) (nearest town)

WELL PURPOSE: home  
 (home, irrigation, municipal, industrial)

WELL COMPLETION DATA:

- (1) diameter (inches) 2"
- (2) total depth (feet) 190
- (3) static water level (feet) 55' below above top of ground.
- (4) casing PVC, 190  
 (material) (depth)
- no if telescope see back.  
 (size)
- (5) screen 10, 190  
 (length) (depth to top)
- 12, PVC  
 (size) (material)
- (6) pump no  
 (HP) (yield gpm)


(type power)

(7) electric log no  
 (yes or no)

(organization running log)

(8) how well bottom plugged good  
shale


DRILLERS REMARKS: no pump furnished

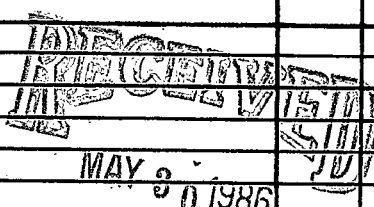

Department of Natural Resources  
 Bureau of Land & Water Resources

If well telescopes please  
sketch and show depths.

GROUND LEVEL

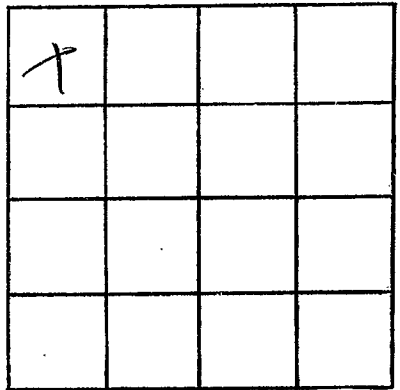

SECTION \_\_\_\_\_

Please indicate well location X.

ADDITIONAL INFORMATION

If more than one screen,  
show locations of each on sketch.