

MISSISSIPPI DEPARTMENT OF NATURAL RESOURCES

Bureau of Land and Water Resources

Southport Mall

P.O. Box 10631

Jackson, Mississippi 39209

WATER WELL DRILLERS LOG

PEARL RIVER
A 2023

9/12 1986 Clean Water Drilling Pearl River
date well completed firm name county well located

LANDOWNER: Bobby Coch
Fords Creek Mo

description of formations encountered	from	to
Top Soil	0	3"
Top Soil	0	3"
Clay + Sand	3"	4'
Top Sand	4'	90'
White Sand	30	90
White Sand + Peabond	90	130

39970
(mailing address)

WELL LOCATION:
sec. 30 T. 1 N. R. 17 E.
12 miles E of Poplarville
(distance) (direction) (nearest town)

WELL PURPOSE:
(home) Irrigation, municipal, industrial

- WELL COMPLETION DATA:
- (1) diameter (inches) 2"
 - (2) total depth (feet) 130
 - (3) static water level (feet) 70 below top of ground.
 - (4) casing PVC 120
(material) (depth)
 - 10' if telescope see back.
(size)
 - (5) screen 10' 120
(length) (depth to top)
 - 012 PVC Slot
(size) (material)
 - (6) pump 1/2 14
(HP) (yield gpm)
 - 220 ✓
(type power)
 - (7) electric log _____
(yes or no)
 - _____
(organization running log)
 - (8) how well bottom plugged SS

DRILLERS REMARKS:


RECEIVED

NOV 21 1986

Department of Natural Resources
Bureau of Land & Water Resources

If well telescopes please
sketch and show depths.

GROUND LEVEL

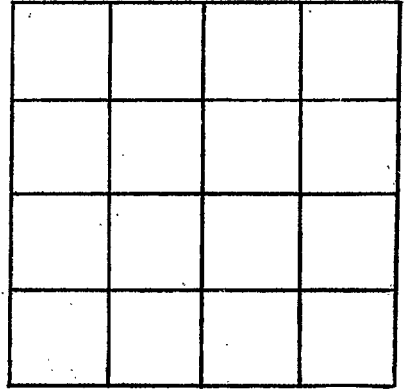

SECTION _____

Please indicate well location X.

ADDITIONAL INFORMATION

If more than one screen,
show locations of each on sketch.