

MISSISSIPPI DEPARTMENT OF NATURAL RESOURCES

Bureau of Land and Water Resources

Southport Mall

P.O. Box 10631

Jackson, Mississippi 39209

WATER WELL DRILLERS LOG

BUD PENTON & SONS

*Pearl River*

Water Well Service County well located

Rt. 4, Box 402

Carriere, Mississippi 39426

Phone 601-398-5324

from

to

PEARL RIVER  
A 2025

6/25 1987  
date well completed

LANDOWNER: Gay N Krügge  
R.T. 1 Box 115-H  
Peplawill, Miss  
(mailing address)

WELL LOCATION:  
sec. 34 T 1 N R 17 E  
(S) (W)  
16 miles North of Carriere  
(distance) (direction) (nearest town)

WELL PURPOSE: Home  
(home, irrigation, municipal, industrial)

WELL COMPLETION DATA:

- (1) diameter (inches) 4
- (2) total depth (feet) 162
- (3) static water level (feet) 70 below above top of ground.
- (4) casing pvc 162  
(material) (depth)
- 20 if telescope see back.  
(size)
- (5) screen 10 15-2  
(length) (depth to top)
- 12 pvc  
(size) (material)
- (6) pump 1 18  
(HP) (yield gpm)
- Elect  
(type power)
- (7) electric log no  
(yes or no)

(organization running log)

(8) how well bottom plugged Shark

DRILLERS REMARKS:

<u>Red shale</u>	<u>0</u>	<u>142</u>
<u>Red sand</u>	<u>42</u>	<u>80</u>
<u>White shale</u>	<u>20</u>	<u>110</u>
<u>Red sand</u>	<u>110</u>	<u>162</u>


RECEIVED

AUG 13 1987

Department of Natural Resources  
Bureau of Land & Water Resources

If well telescopes please sketch and show depths.

GROUND LEVEL

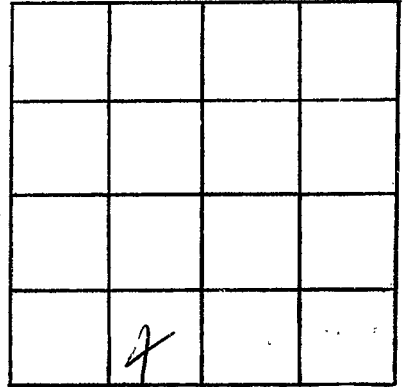

SECTION \_\_\_\_\_

Please indicate well location X.

ADDITIONAL INFORMATION

If more than one screen,  
show locations of each on sketch.