

P. River
A 2020

MISSISSIPPI DEPARTMENT OF NATURAL RESOURCES
Bureau of Land and Water Resources
Southport Mall
P.O. Box 10631
Jackson, Mississippi 39209
WATER WELL DRILLERS LOG

3/13/88 date well completed
Elean Water Drilling Pearl River firm name
Pearl River county well located


LANDOWNER: James A. Gardner
Fords Creek
Poplarville MO. 39476
(mailing address)

WELL LOCATION:
sec. 29 T-1 N R-17 E
7 miles NE of Poplarville
(distance) (direction) (nearest town)

WELL PURPOSE: Home
(home, irrigation, municipal, industrial)

WELL COMPLETION DATA:
(1) diameter (inches) 4"
(2) total depth (feet) 200'
(3) static water level (feet) 58' below top of ground.
(4) casing PVC, 190' (material) (depth)
if telescope see back.
(5) screen 10' length, 190' depth to top
8" Ø 10 PVC slot (size) (material)
(6) pump 1 HP, 28 yield gpm
220V (type power)
(7) electric log (yes or no)
(organization running log)
(8) how well bottom plugged B.W.

description of formations encountered	from	to
yellow clay	0	15
yellow Red clay	15	30
Tan Sand	30	40
yellow clay	40	70
Blue clay	70	168
fine tan sand	160	178
med to coarse tan sand	178	200

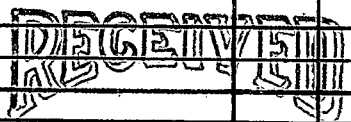


FEB 10 1988

Department of Natural Resources
Bureau of Land & Water Resources

DRILLERS REMARKS:

If well telescopes please sketch and show depths.

GROUND LEVEL

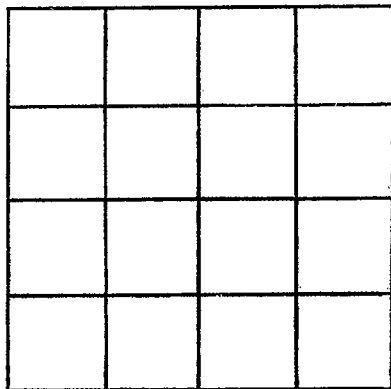

SECTION _____

Please indicate well location X.

ADDITIONAL INFORMATION

If more than one screen, show locations of each on sketch.