

P. RIVER
A
2028

MISSISSIPPI DEPARTMENT OF NATURAL RESOURCES
Bureau of Land and Water Resources
Southport Mall
P.O. Box 10631
Jackson, Mississippi 39209
WATER WELL DRILLERS LOG

7-14 1990 Hollinger Well Service Pearl River County
date well completed firm name county well located

LANDOWNER: Quitman Lewis
Baxterville, MS.

description of formations encountered	from	to
Sand gravel	0	120
Chalk	120	200
Sand, gravel	200	260

(mailing address)

WELL LOCATION:
sec. 4 T. 1 N. R. 17 E.
10 miles S of Baxterville
(distance) (direction) (nearest town)

WELL PURPOSE:
(home, irrigation, municipal, industrial)

WELL COMPLETION DATA:

- (1) diameter (inches) 4"
- (2) total depth (feet) 260
- (3) static water level (feet) 160 below top of ground.
- (4) casing PVC, 250,
(material) (depth)
if telescope see back.
(size)
- (5) screen 10, 250
(length) (depth to top)
4", PVC
(size) (material)
- (6) pump 1, 20
(HP) (yield gpm)
elect
(type power)
- (7) electric log _____
(yes or no)
(organization running log)

(8) how well bottom plugged Sand
Shale


DRILLERS REMARKS: Very good well

RECEIVED
JUL 23 1990

Department of Natural Resources
Bureau of Land & Water Resources

If well telescopes please sketch and show depths.

GROUND LEVEL

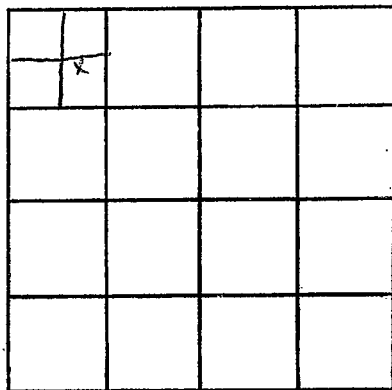

SECTION 4

Please indicate well location X.

ADDITIONAL INFORMATION

If more than one screen,
show locations of each on sketch.