

P. RIVER  
A 2030

MISSISSIPPI DEPARTMENT OF NATURAL RESOURCES  
 Bureau of Land and Water Resources  
 Southport Mall  
 P.O. Box 10631  
 Jackson, Mississippi 39209  
**WATER WELL DRILLERS LOG**

3/6/91 19 Clear Water Drilling Pearl River  
 date well completed firm name county well located


LANDOWNER: James Barge  
PO Box 226  
Poplarville MS 39470  
 (mailing address)

WELL LOCATION:  
 sec. 23 T 4N R. 17 E  
8 miles E of Poplarville  
 (distance) (direction) (nearest town)

WELL PURPOSE: HOME  
 (home, irrigation, municipal, industrial)

WELL COMPLETION DATA:  
 (1) diameter (inches) 4"  
 (2) total depth (feet) 205'  
 (3) static water level (feet) 60' below above top of ground.  
 (4) casing PVC, 195'  
 (material) (depth)  
 \_\_\_\_\_ if telescope see back.  
 (size)  
 (5) screen 10', 195'  
 (length) (depth to top)  
 - 010, PVC  
 (size) (material)  
 (6) pump 1/2, 12  
 (HP) (yield gpm)  
230V  
 (type power)  
 (7) electric log \_\_\_\_\_  
 (yes or no)  
 \_\_\_\_\_  
 (organization running log)  
 (8) how well bottom plugged BW Valve

description of formations encountered	from	to
top soil	0	9"
Dark to yellow clay	9"	30'
Red sand	30'	90'
Red sand + gravel	40	50
Blue clay	50	120
Blue clay fine sand	120	135
Blue clay	135	140
fine sand blue clay	140	170
Med to coarse sand	170	190
coarse tan sand gravel	190	205

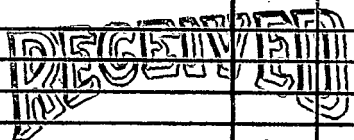


MAR 21 1991

Dept. of Environmental Quality  
 Bureau of Land & Water Resources

DRILLERS REMARKS:

If well telescopes please sketch and show depths.

GROUND LEVEL

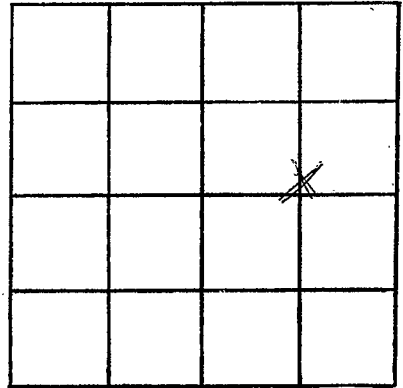

SECTION 23

Please indicate well location X.

ADDITIONAL INFORMATION

If more than one screen,  
show locations of each on sketch.