

MISSISSIPPI DEPARTMENT OF NATURAL RESOURCES

Bureau of Land and Water Resources

P.O. Box 10631

Jackson, Mississippi 39209

WATER WELL DRILLERS LOG

COUNTY WELL LOCATED
Pearl River
 WELL NUMBER A CODED
2038
 DATE WELL COMPLETED
5-28-93

PERMIT NUMBER 0-477
 NAME OF DRILLING FIRM
PENTON WELL
Nicholson, MS.

NAME & MAILING ADDRESS OF LANDOWNER
ROY RITTER
2416 MALLARD ST.
Slidell, LA. 70460
 WELL LOCATION: SEC 20 TOWNSHIP 41 RANGE 17
S W
 DISTANCE 1 1/2 MILES DIRECTION W. NEAREST TOWN Mill Creek
 OTHER ~~LOCATION~~ Carriere
Location # 30 Hillcrest, MS.
 WELL PURPOSE Home, Irrigation, Municipal, Industrial, Fish Pond, etc.

PUMP DATA
 PUMP TYPE (Circle One):
 Submersible, Turbine, Jet Flowing Well,
 Other (Describe) _____
 POWER TYPE (Circle One):
 Electric, Tractor, Diesel, Gasoline, Butane,
 Other (Describe) _____ H/P _____
 Pump Capacity (GPM) 15 No. of Stages _____ Setting Depth _____ FT.
 PUMP TEST
 Well yielded _____ GPM with
 a drawdown of _____ ft.
 after _____ hours of pumping

WELL DATA
 Well Depth 585 Casing Diameter (In.) 4 x 2 Casing Length (Ft.) 570
 Type of Casing PVC Hole Depth 585 Depth to Static Water Level 120'
 TYPE OF COMPLETION: (Circle One or More):
 Gravel Packed, Underreamed, Telescoped,
 Natural Development, Open Hole, Other
 (Describe) _____
 Top of Lap Pipe or Reduction in Casing:
220 FEET IF TELESCOPED OR MORE THAN ONE SCREEN: USE BACK PAGE

LOG DATA
 TYPE OF LOG RUN (Circle One): No Log Run,
 Electric, Gamma Ray, Density, Sonic, Neutron,
 Other (Describe) _____
 Name of Organization Running Log _____

SCREEN DATA
 Diameter - Inches 2 Length - Feet 15 Slot Size - Inches 10
 Screen Type PVC Depth to Bottom - Feet 52-585

GEOLOGIC DATA (Office Use Only)

Surface Elev.	Geologic Unit	Unit Thickness	Depth to Top
Subs. SWL	Date	Analysis	Aquifer Test


 Driller's Remarks _____

DESCRIPTION OF FORMATIONS ENCOUNTERED	FROM	TO	FORMATIONS (Continued)	FROM	TO
<u>R. Sand</u>	<u>0</u>	<u>150</u>	<div style="font-size: 2em; font-weight: bold; border: 2px solid black; padding: 5px; display: inline-block;">RECEIVED</div> <u>JUN 28 1993</u> Dept. of Environmental Quality Office of Land & Water Resources		
<u>Clay</u>	<u>150</u>	<u>240</u>			
<u>Sand</u>	<u>240</u>	<u>315</u>			
<u>Clay</u>	<u>315</u>	<u>450</u>			
<u>Sand</u>	<u>450</u>	<u>585</u>			

IF MORE SPACE IS NEEDED, USE BACK

If well telescopes please sketch and show depths.

GROUND LEVEL

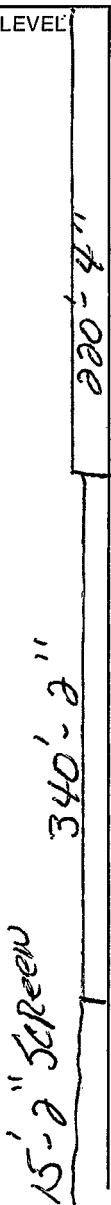

	X		

SECTION 20

Please indicate well location X.

ADDITIONAL INFORMATION

If more than one screen, show location of each on sketch.