

PEARL RIVER
B4
6-9-72

MISSISSIPPI
BOARD OF WATER COMMISSIONERS
416 North State Street
Jackson, Mississippi 39201

CODED

WATER WELL DRILLERS LOG

June 9 1972 date well completed
Easley Staffer Water Well Service firm name
Pearl River county well located

LANDOWNER: Mack R. Lambert
Rt 1, Box 94 A
Poplarville, Miss.
(mailing address)

description of formations encountered	from	to
Top Soil	0	10
Clay	10	60
Sand	60	75
Chalk	75	175
Sand & Gravel	175	252

WELL LOCATION:
sec. 6 T. 1 S. R. 16 W.
_____ miles _____ of _____
(distance) (direction) (nearest town)

WELL PURPOSE:
(home, irrigation, municipal, industrial)

WELL COMPLETION DATA:

(1) diameter (inches) 4

(2) total depth (feet) 252

(3) static water level (feet) _____ below above top of ground.

(4) casing Plastic, 232 ft
(material) (depth)
4 in if telescope see back.
(size)

(5) screen 20 232
(length) (depth, to top)
4 in, Plastic
(size) (material)

(6) pump 1 _____
(HP) (yield gpm)
Elec.
(type power)

(7) electric log _____
(yes or no)

_____ (organization running log)

(8) how well bottom plugged B.W.V.


CODED

MISS. REG. 1972
RECEIVED

DRILLERS REMARKS:
Cherie Duncan

If well telescopes please sketch and show depths.

GROUND LEVEL

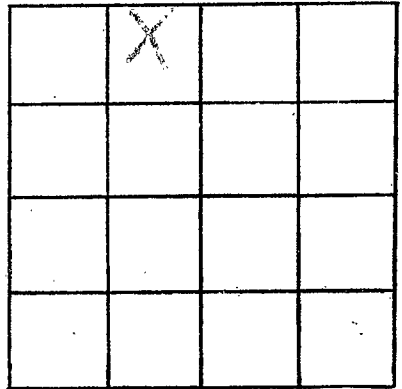

SECTION _____

Please indicate well location X.

ADDITIONAL INFORMATION

A series of horizontal lines for writing additional information, starting below the 'ADDITIONAL INFORMATION' header and extending to the bottom of the page.

If more than one screen, show locations of each on sketch.