

**PEARL RIVER**  
**B6**  
**5-7-73**

MISSISSIPPI  
 BOARD OF WATER COMMISSIONERS  
 416 North State Street  
 Jackson, Mississippi 39201

**CODED**

WATER WELL DRILLERS LOG

5/7/73 1973 Bud Penton's Son Pearl River  
 date well completed firm name county well located

LANDOWNER Anthony Berkeci  
Poplarville Miss  
 (mailing address)

description of formations encountered	from	to
white shale	0	27
Red sand	22	31
Blue shale	31	120
Blue sand	120	144
Blue shale	144	185
Blue sand	185	255
Blue shale	255	475
Blue sand	475	608

WELL LOCATION:  
 sec. 29 T. 1 N. R. 16 E.  
7 miles E of Poplarville  
 (distance) (direction) (nearest town)

WELL PURPOSE: home  
 (home, irrigation, municipal, industrial)

WELL COMPLETION DATA:

- (1) diameter (inches) 4 X 2
- (2) total depth (feet) 600
- (3) static water level (feet) 105 <sup>below</sup> ~~above~~ top of ground.
- (4) casing galv 585  
 (material) (depth)  
4 X 2 if telescope see back.  
 (size)
- (5) screen 15 585  
 (length) (depth to top)  
2 X 1/2 Galv. 7014  
 (size) (material)
- (6) pump 2 5700  
 (HP) (yield gpm)  
Elect  
 (type power)
- (7) electric log \_\_\_\_\_  
 (yes or no)
- (8) how well bottom plugged Seal  
Shark

**CODED**

DRILLERS REMARKS:

MISSISSIPPI BOARD OF WATER COMMISSIONERS


If well telescopes please sketch and show depths.

GROUND LEVEL

268-4M



348-2-1

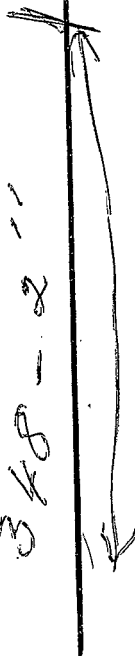

	X		

SECTION \_\_\_\_\_

Please indicate well location X.

ADDITIONAL INFORMATION

If more than one screen, show locations of each on sketch.