

Pearl River
 B 7
 5-16-73

MISSISSIPPI
 BOARD OF WATER COMMISSIONERS
 416 North State Street
 Jackson, Mississippi 39201

CODED

WATER WELL DRILLERS LOG

5/16 1973 Bud Peterson Pearl River
 date well completed firm name county well located

LANDOWNER: Claud Staudt
Poplarville Miss.
 (mailing address)

description of formations encountered	from	to
Red shale	0	12
Red sandstone	12	34
White shale	34	215
Blue shale	215	471
Blue sand	471	503

WELL LOCATION:
 sec. 27 T 1 N R 16 E
 (distance) miles (direction) of (nearest town)

WELL PURPOSE:
 (home, irrigation, municipal, industrial)

WELL COMPLETION DATA:

- (1) diameter (inches) 4 1/2
- (2) total depth (feet) 503
- (3) static water level (feet) 191 below/above top of ground.
- (4) casing gal (material), 488 (depth)
4 1/2 (size) if telescope see back.
- (5) screen 15 (length), 488 (depth to top)
2x15 (size), gal (material)
- (6) pump 2 (HP), 900 (yield gpm)
elect (type power)
- (7) electric log (yes or no)

CODED

(organization running log)
 (8) how well bottom plugged part
shark


DRILLERS REMARKS:

FORM 6-1 (REV. 1-73)

If well telescopes please sketch and show depths.

GROUND LEVEL

25-1 x 2" / 25-2 x 4"

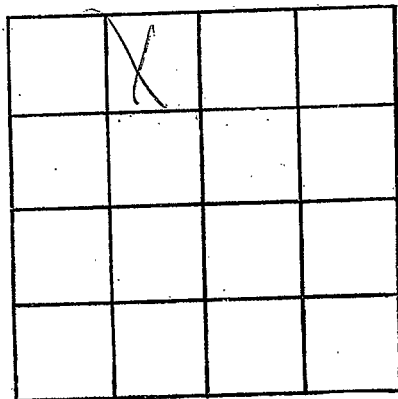

SECTION _____

Please indicate well location X.

ADDITIONAL INFORMATION

If more than one screen, show locations of each on sketch.