

PEARL River  
 B 8  
 4-3-73

MISSISSIPPI  
 BOARD OF WATER COMMISSIONERS  
 416 North State Street  
 Jackson, Mississippi 39201

**CODED**

WATER WELL DRILLERS LOG

4/73 date well completed 1973 Bud Penton firm name Pearl River county well located

LANDOWNER: P. W. Miller  
 Poplarville Miss.  
 (mailing address)

description of formations encountered	from	to
Red shale	0	18
Red sand	18	30
Blue shale	30	105
White sand	105	130

WELL LOCATION:  
 sec 29 T 1 N R 16 E  
 6 miles NW of Poplarville

WELL PURPOSE: farm  
 (home, irrigation, municipal, industrial)


- WELL COMPLETION DATA:
- (1) diameter (inches) 4"
  - (2) total depth (feet) 130
  - (3) static water level (feet) 63 below top of ground
  - (4) casing PVC 115' (material) (depth)
  - (5) screen 4x10 115' (length) (depth to top)  
 4x10 PVC (size) (material)
  - (6) pump 1 (HP) 1200 (yield gpm)  
 Elect. (type power)
  - (7) electric log (yes or no)
  - (8) how well bottom plugged Shorford

**CODED**

DRILLERS REMARKS:

If well telescopes please sketch and show depths.

GROUND LEVEL

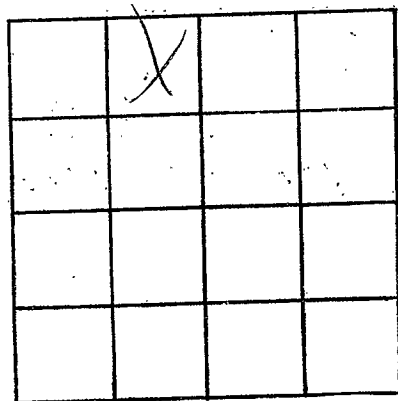

SECTION \_\_\_\_\_

Please indicate well location X.

ADDITIONAL INFORMATION

If more than one screen,  
show locations of each on sketch.