

MISSISSIPPI
BOARD OF WATER COMMISSIONERS
416 North State Street
Jackson, Mississippi 39201

CODED

WATER WELL DRILLERS LOG

PEARL RIVER
B9
5-25-73
5-25

1973 Horace A. Poole Pearl River
date well completed firm name county well located

LANDOWNER: Fimmie Brooks description of formations encountered from to
RT# 3 CLAY 0 357
POPLARVILLE MISS SILT + SAND 357 400
(mailing address) SAND + CLAY 400 432
SAND 432 468

WELL LOCATION:
sec. 15 T. 1 N. R. 16 W.
S W
5 miles NW of Poplarville
(distance) (direction) (nearest town)

WELL PURPOSE: Home
(home, irrigation, municipal, industrial)

- WELL COMPLETION DATA:
- (1) diameter (inches) 4 1/2
 - (2) total depth (feet) 468
 - (3) static water level (feet) 130 below top of ground.
 - (4) casing Galv (material) (depth)
2" (size) if telescope see back.
 - (5) screen 3 465 (length) (depth to top)
2x3 STAINLESS STEEL (size) (material)
 - (6) pump 1 (HP) (yield gpm)
Elec (type power)
 - (7) electric log no (yes or no)
 - (organization running log)
 - (8) how well bottom plugged Backward Valve

CODED


DRILLERS REMARKS:

JUN 28 1973

MISSISSIPPI
MAY 20 1973

If well telescopes please sketch and show depths.

GROUND LEVEL

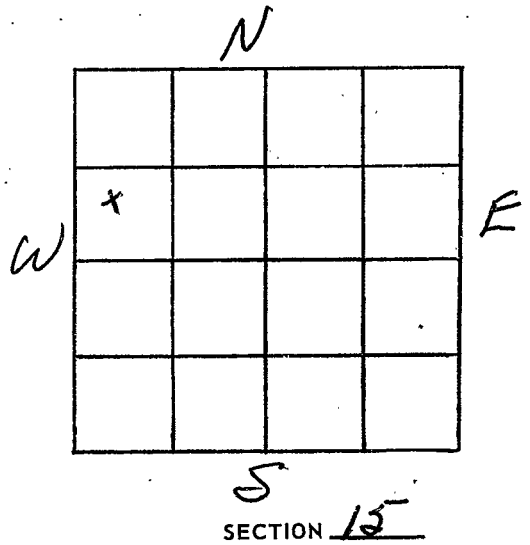

Please indicate well location X.

ADDITIONAL INFORMATION

If more than one screen, show locations of each on sketch.