

PEARL RIVER  
 B 10  
 5-27-73

MISSISSIPPI  
 BOARD OF WATER COMMISSIONERS  
 416 North State Street  
 Jackson, Mississippi 39201

**CODED**

WATER WELL DRILLERS LOG

5-27 1973 Hot Ace A Poole Pearl River  
 date well completed firm name county well located

LANDOWNER: Se Roy Bilbo  
 RT # 1  
Poplarville Miss  
 (mailing address)

description of formations encountered	from	to
	<u>SANDY CLAY</u>	<u>0</u>
<u>SAND &amp; GRAVEL</u>	<u>20</u>	<u>56</u>

WELL LOCATION:  
 sec. 16 T. 1 N. R. 16 E.  
 S. W.  
12 miles N of Poplarville  
 (distance) (direction) (nearest town)

WELL PURPOSE: Home  
 (home, irrigation, municipal, industrial)

- WELL COMPLETION DATA:
- (1) diameter (inches) 4 1/2
  - (2) total depth (feet) 56
  - (3) static water level (feet) \_\_\_\_\_ below above top of ground.
  - (4) casing Pvc 51'  
 (material) (depth)  
2" if telescope see back.  
 (size)
  - (5) screen 5 51'  
 (length) (depth to top)  
2 Pvc  
 (size) (material)
  - (6) pump 3/4 6  
 (HP) (yield gpm)  
Gas  
 (type power)
  - (7) electric log no  
 (yes or no)
- (organization running log)
- (8) how well bottom plugged BACK WASH VALVE


**CODED**

JAN 29 1973

DRILLERS REMARKS:

If well telescopes please sketch and show depths.

GROUND LEVEL

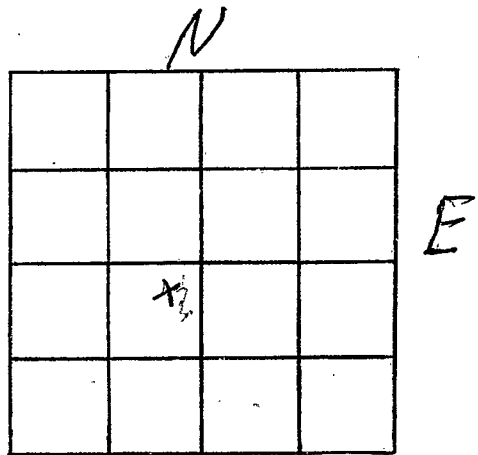

S  
SECTION 11

Please indicate well location X.

ADDITIONAL INFORMATION

If more than one screen,  
show locations of each on sketch.