

Pearl River
B 13
2-15-74

MISSISSIPPI
BOARD OF WATER COMMISSIONERS
416 North State Street
Jackson, Mississippi 39201

CODED

WATER WELL DRILLERS LOG

Feb 15 1974 Pearl River Water Well Pearl River
date well completed firm name county well located

LANDOWNER: Frank B Hayne

description of formations encountered

from

to

226 Exumance St
Mandeville La 70448
(mailing address)

Top Chalk

0 2'

Fine sand

2.5 5.5'

WELL LOCATION:

sec 19 T 1 N R 16 E
15 miles NW of Poplarville
(distance) (direction) (nearest town)

Blue Chalk

5.5 6.3

Fine sand

6.3 11.5

Red Mass Blue Chalk

11.5 19.5

Fine sand

19.5 22.5

Coarse sand

22.5 26.0'

WELL PURPOSE: Home
(home, irrigation, municipal, industrial)

WELL COMPLETION DATA:

- diameter (inches) 4" PVC
- total depth (feet) 26.0
- static water level (feet) 90 below top of ground.
- casing PVC 26.0 (material) (depth) (size) If telescope see back.
- screen 10' 250 (length) (depth to top) 4" Sch 40 (size) (material)
- pump 1/2 8 (HP) (yield gpm) 220 volts 110 (type power)
- electric log (yes or no)

(organization running log)


(8) how well bottom plugged 2" sand filter & valve.

DRILLERS REMARKS:

CODED
MAR 21 1974
MISS. BD. OF WATER COMMISSIONERS

If well telescopes please sketch and show depths.

GROUND LEVEL

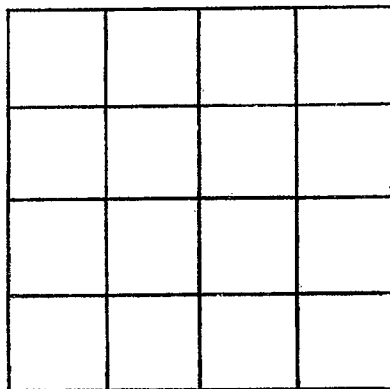

SECTION _____

Please indicate well location X.

ADDITIONAL INFORMATION

If more than one screen,
show locations of each on sketch.