

Pearl River  
 B14  
 4-A-75

MISSISSIPPI  
 BOARD OF WATER COMMISSIONERS  
 416 North State Street  
 Jackson, Mississippi 39201

WATER WELL DRILLERS LOG

COPIED

APRIL 4 1975 HAROLD Woodward PEARL RIVER  
 date well completed firm name county well located

LANDOWNER: OCON CULPEPPER  
 Rt. 1 Box Poplarville  
 (mailing address)

WELL LOCATION:  
 sec. 30 T. 1 N. R. 16 E.  
 S W  
 10 miles NW of Poplarville  
 (distance) (direction) (nearest town)

WELL PURPOSE: HOME  
 (home, irrigation, municipal, industrial)

- WELL COMPLETION DATA:
- (1) diameter (inches) 2"
  - (2) total depth (feet) 315'
  - (3) static water level (feet) 85' below above top of ground.
  - (4) casing PLASTIS, 365 (material) (depth)  
 (size) if telescope see back.
  - (5) screen 12' 305' (length) (depth to top)  
 2" PLASTIC (size) (material)
  - (6) pump 1 10 (HP) (yield gpm).  
 115V AC (type power)
  - (7) electric log NO (yes or no)  
 SELF (organization running log)
  - (8) how well bottom plugged 2" S S  
 B.W. DAULE


description of formations encountered	from	to
RED CLAY	0	18'
FINE SAND	18'	23'
BROWN SAND	23'	35'
WHITE CLAY	35'	60'
PINK CLAY	60'	90'
BLUE CLAY	90'	193'
HARD ROCK 6"	193'	194'
BLUE CLAY	195'	230'
FINE SAND	230'	240'
BLUE CLAY	240'	252'
BLUE SAND	252'	269'
BLUE SAND & Gravel	269'	315'
VERY COARSE SAND & GRAVEL		
SET AT 315'		
SET IN 33' COARSE SAND & GRAVEL		

DRILLERS REMARKS:

RECEIVED  
 APR 11 1975

If well telescopes please sketch and show depths.

GROUND LEVEL

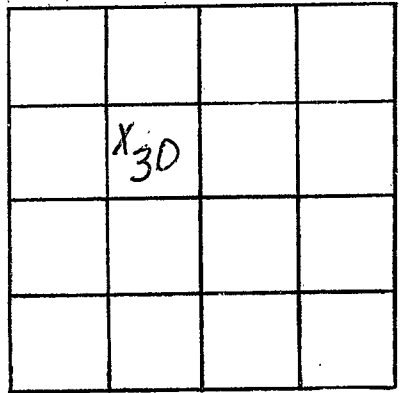

SECTION 30

Please indicate well location X.

ADDITIONAL INFORMATION

If more than one screen,  
show locations of each on sketch.