

MISSISSIPPI DEPARTMENT OF NATURAL RESOURCES

Bureau of Land and Water Resources
 Southport Mall
 P.O. Box 10631
 Jackson, Mississippi 39209
 PHONE 798-5324

Reson PENTON & SON
 WATER WELL SERVICE
 ROUTE 4 BOX 440
 CARRIER, MS 39426
 PHONE 798-5324

BUD PENTON & SON
 WATER WELL SERVICE
 WATER WELL DRILLERS LOG
 CARRIER, MS 39426
 PHONE 798-5324

COPIED

Pearl River
 B33
 7-18-82

7/18 1982
 date well completed

firm name

Pearl River
 county well located

LANDOWNER: Raymond M
Bocher P.T. 1 Box 38A
poplarville miss.
 (mailing address)

description of formations encountered	from	to
Red shale	0	20
Red sand	20	45
Blue shale	45	504
White sand	504	531
Blue shale (MPT)	531	625
Grey sand	625	885

WELL LOCATION:
 sec. 25 T 1 N R 16 E
 (S) (W)
4" miles 7 of poplarville
 (distance) (direction) (nearest town)

WELL PURPOSE:
 (home, irrigation, municipal, industrial)
farm

- WELL COMPLETION DATA:
- (1) diameter (inches) 4"
 - (2) total depth (feet) 885
 - (3) static water level (feet) 168 below above top of ground.
 - (4) casing pvc, 685
 (material) (depth)
70 If telescope see back.
 (size)
 - (5) screen 4x20, 665
 (length) (depth to top)
12, pvc
 (size) (material)
 - (6) pump 5, 60
 (HP) (yield gpm)
Ele 1
 (type power)
 - (7) electric log no
 (yes or no)

(organization running log)

(8) how well bottom plugged short

DRILLERS REMARKS:


DEPT. OF NATURAL RESOURCES
 BUREAU OF LAND & WATER RESOURCES

SEP - 1 1982

RECEIVED

If well telescopes please sketch and show depths.

GROUND LEVEL

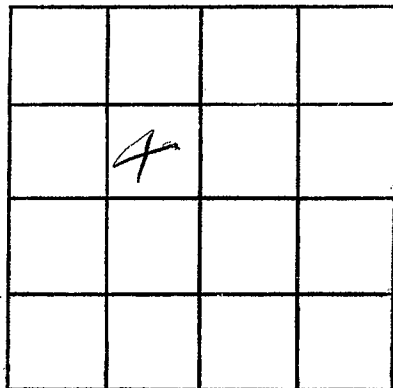

SECTION _____

Please indicate well location X.

ADDITIONAL INFORMATION

If more than one screen,
show locations of each on sketch.