STATE WELL REPORT					
County: Pearl river Permit #: Driller: Scott Boone Date drilling completed: 01/30/2022  State Law requires that this report Department at the above address w Well Owner Informati (Landowner if borehole is not for Owner Name: Gary parnigon Mailing Address: 300 or Stanf	Mississippi Depart Office of La Jacks ( (60 be prepared by the ithin 30 days of con a water well)	mpletion of drilling of the well of Well or Bore Latitude: <u>30.9899610</u> Lon Method of Lat/Long (check one USGS quad, Hand-held G	elev 355 he work and filed withor borehole. chole Location ngitude: -89.554 c): Conventional Surve PS V, Survey-grade	RECEIVED         03-09-2022 <i>b</i> the <b>BY OLWR</b> 7320         ey,         GPS	
Lumberton MS City State Telephone No. (228) 305-0334	39456 Zip Code	<u>NE</u> 1/4 <u>SW</u> 1/4, Sec_ Miles <u>(Distance)</u> (Direction)	01T01S f (Nearest Tow		
	drilling completed: vater used for drillin ne used in drilling a un⊡Electric Gamm Well ⊡ Geotechni ic Survey Other o	ng: <u>Pond</u> nd development: <u>Granula</u> na Ray Density Sonic Neutro	<b>r</b> on Other: Ground Source Heat Pu		
Purpose of Well (check all applicable): Other (describe): If a flowing well, method of flow regula Static Water Level: 27 feet Method of measurement (check one): Well depth: 70 Well grouted to a Casing length: 50 feet Ca Screen length: 20 feet S Screen slot size: .08 inches Type of completion (check all applicable Other (describe): Top of lap pipe or reduction in casing:	ation: Valve [ above or 🗹 belo (check one) Steel tape 🗹 Electric depth of: <u>10</u> f asing diameter: <u>4</u> creen diameter: <u>4</u> Setting depth: e): Gravel packed	Other ( <i>describe</i> ) ow] land surface Date measur tape Air line Other ( <i>describe</i> ) eet Type of grout ( <i>check one</i> ) inches Type of c inches Type of s From <u>50</u> feet to Underreamed Open hole	ed: 01/30/202 ): Neat Cement Bento casing: PVC screen: PVC 5 70 Natural Developme	22 onite Mix feet	
If telescoped or more than one screen, describe on next page					

County:	Pearl river
Permit #:	




For Office Use Only:

Well #: \_\_\_\_\_B58

## The sketch below only required for water wells

If well telescopes, show depths on sketch.

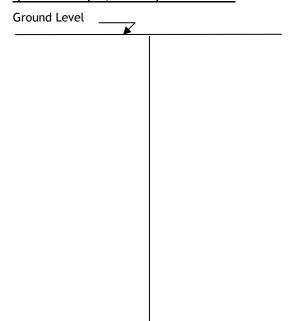

Description of formations encountered must be provided for all wells and boreholes, unless specifically exempted by regulations

Description of Formations Encountered	From ( <i>depth</i> )	To (depth)
Orange clay	Ground level	17
Sand	17	50
Gravel	50	70

If more than one screen, show location of each on sketch

Sketch the property layout and include the following:

1) the well location

2) any permanent structures on the property that may aid in locating the well

3) any roads, power lines, or other items that may aid in locating the property and the well

4) north arrow



requirements of the Mississippi Department of Environmental Quality and the Mississippi Department of Health regulations, if applicable, and state laws.

Scott Boone 6262 Print Name of Responsible Licensee and License No.

03/08/2022 Date



Scott Boone Signature of Licensee