

Pearl River
B 2001
8/2/77

MISSISSIPPI
 BOARD OF WATER COMMISSIONERS
 416 North State Street
 13V Jackson, Mississippi 39201

WATER WELL DRILLERS LOG

8/2/77 1977 Hollingson Well Pearl River
 date well completed firm name county well located
Service

LANDOWNER:	description of formations encountered	from	to
<u>Capt. Kenneth Davis</u>			
<u>Poplarville, Miss</u> (mailing address)	<u>C/Brk</u>	<u>0</u>	<u>30</u>
	<u>CHALK</u>	<u>30</u>	<u>80</u>
	<u>SAND, GRAVEL</u>	<u>80</u>	<u>127</u>

WELL LOCATION:
 sec 19 T 1 N R 16 E
4 1/2 miles SE of Ford Creek
 (distance) (direction) (nearest town)

WELL PURPOSE: Home
 (home, irrigation, municipal, industrial)

- WELL COMPLETION DATA:
- (1) diameter (inches) 2"
 - (2) total depth (feet) 127
 - (3) static water level (feet) 80 below top of ground.
 - (4) casing PVC, 122
 (material) (depth)
 (size) if telescope see back.
 - (5) screen 5, 122
 (length) (depth to top)
2, PVC
 (size) (material)
 - (6) pump 1, 7
 (HP) (yield gpm)
elect
 (type power)
 - (7) electric log
 (yes or no)
 - (organization running log)
 - (8) how well bottom plugged SAND
SHARK

DRILLERS REMARKS: VERY
good


RECEIVED

SEP 10 1977

Miss. Bd. OF WATER COMMISSIONERS

If well telescopes please sketch and show depths.

GROUND LEVEL

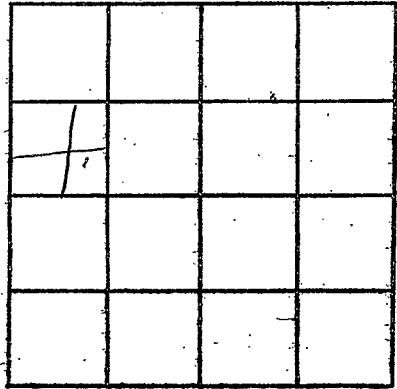

SECTION 19

Please indicate well location X.

ADDITIONAL INFORMATION

A series of horizontal lines for recording additional information, starting below the 'ADDITIONAL INFORMATION' header and extending to the bottom of the page.

If more than one screen, show locations of each on sketch.