

| |
|-------------|
| PEARL RIVER |
| B |
| 2003 |

**MISSISSIPPI
BOARD OF WATER COMMISSIONERS**
416 North State Street
Jackson, Mississippi 39201

WATER WELL DRILLERS LOG

July 19, 1978 Nixie Water Well Pump, Inc. Pearl River
 date well completed firm name county well located

LANDOWNER: Mrs. Lois M. Nelson
Rt. 1 - Box 74-L
Poplarville, Ms. 39470
 (mailing address)

| description of formations encountered | from | to |
|---------------------------------------|-------------------|-----------|
| | <u>White Clay</u> | <u>0</u> |
| <u>Coarse White Sand</u> | <u>55</u> | <u>85</u> |

WELL LOCATION:
 sec 7 T 1 N R 16 E
17? miles (West) of Poplarville
 (distance) (direction) (nearest town)

WELL PURPOSE: Home
 (home, irrigation, municipal, industrial)

- WELL COMPLETION DATA:
- diameter (inches) 2"
 - total depth (feet) 85'
 - static water level (feet) 35 below above top of ground.
 - casing P.V.C. 75'
 (material) (depth)
2" If telescope see back.
 (size)
 - screen 10' 75'
 (length) (depth to top)
2" P.V.C.
 (size) (material)
 - pump 1 Electric
 (HP) (yield gpm)
 (type power)
 - electric log no
 (yes or no)
 (organization running log)
 - how well bottom plugged Sand Shale

RECEIVED


JUL 24 1978

DRILLERS REMARKS: _____

MISS. BD. OF WATER COMMISSIONERS

If well telescopes please sketch and show depths.

GROUND LEVEL

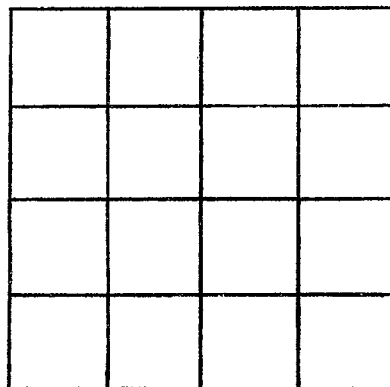

SECTION _____

Please indicate well location X.

ADDITIONAL INFORMATION

If more than one screen, show locations of each on sketch.