

MISSISSIPPI DEPARTMENT OF NATURAL RESOURCES

Bureau of Land and Water Resources

Southport Mall

P.O. Box 10631

Jackson, Mississippi 39209

WATER WELL DRILLERS LOG

PEARL RIVER
B 2004
5/6/81

5/6 date well completed 1981 Red Penton well name Pearl River county well located

LANDOWNER: <u>Tom Colahan</u>	description of formations encountered	from	to
<u>Spring Hill Com.</u>	<u>Red shale</u>	<u>0</u>	<u>18</u>
	<u>Red sand</u>	<u>18</u>	<u>65</u>

(mailing address)


WELL LOCATION:
sec. 35 T 1 N R 16 E
9th miles north of Southport
(distance) (direction) (nearest town)

WELL PURPOSE: home
(home, irrigation, municipal, industrial)

WELL COMPLETION DATA:


- (1) diameter (inches) 2"
- (2) total depth (feet) 65'
- (3) static water level (feet) 32 below above top of ground.
- (4) casing PVC 65'
(material) (depth)
- (size) If telescope see back.
- (5) screen 2x5' 60
(length) (depth to top)
- 12 PVC
(size) (material)
- (6) pump 1/2 450
(HP) (yield gpm)
- Elect.
(type power)
- (7) electric log no.
(yes or no)
- (organization running log)
- (8) how well bottom plugged hard
sharp

DRILLERS REMARKS:

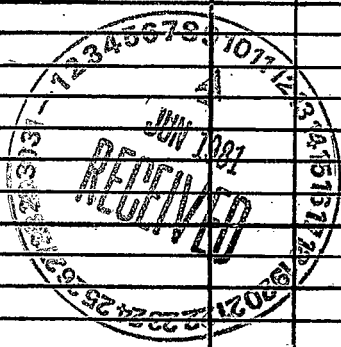

If well telescopes please sketch and show depths.

GROUND LEVEL

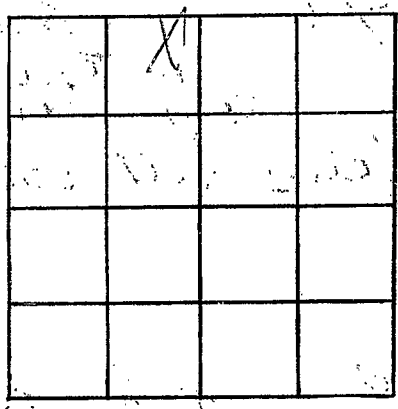

SECTION _____

Please indicate well location X.

ADDITIONAL INFORMATION

Lined area for additional information.

If more than one screen, show locations of each on sketch.