

MISSISSIPPI DEPARTMENT OF NATURAL RESOURCES

Bureau of Land and Water Resources

Southport Mall

P.O. Box 10631

Jackson, Mississippi 39209

WATER WELL DRILLERS LOG

Pearl River  
B 2007

5-19-1982 Hollinger Pearl River Co.  
date well completed firm name county well located

LANDOWNER: <u>Harold Britton</u> <u>Ards Creek Comm.</u> <u>Poplarville, ms.</u> (mailing address)	description of formations encountered	from	to
<p>WELL LOCATION:</p> <p>sec. <u>30</u> T <u>1</u> N R <u>16</u> E  <div style="display: flex; justify-content: space-around; align-items: center;"> <span>(S)</span> <span>(W)</span> </div> <u>12</u> miles <u>W</u> of <u>Poplarville</u>                      (distance) (direction) (nearest town)</p>	<p><u>pipe clay</u> <u>sand, gravel</u> <u>chalk</u> <u>sand</u></p>	<p><u>0</u> <u>20</u> <u>20</u> <u>60</u> <u>60</u> <u>150</u></p>	<p><u>20</u> <u>60</u> <u>150</u> <u>160</u></p>
<p>WELL PURPOSE: (home, irrigation, municipal, industrial)</p>			
<p>WELL COMPLETION DATA:</p> <p>(1) diameter (inches) <u>4</u></p> <p>(2) total depth (feet) <u>160</u></p> <p>(3) static water level (feet) <u>100</u> <sup>below</sup> <sub>above</sub> top of ground.</p> <p>(4) casing <u>PVC</u>, <u>150</u>, (material) (depth)</p> <p>_____ If telescope see back. (size)</p> <p>(5) screen <u>10</u>, <u>150</u> (length) (depth to top)</p> <p><u>4</u>, <u>PVC</u> (size) (material)</p> <p>(6) pump <u>1</u> <u>15</u> (HP) (yield gpm)</p> <p><u>elect.</u> (type power)</p> <p>(7) electric log _____ (yes or no)</p> <p>_____ (organization running log)</p>	<p style="text-align: center; font-size: 2em; opacity: 0.5;">copy</p>		
<p>(8) how well bottom plugged <u>sand</u> <u>shark</u></p> <p>DRILLERS REMARKS: <u>good well</u></p>			


DEPT. OF NATURAL RESOURCES  
BUREAU OF LAND & WATER RESOURCES

NOV 17 1982

RECEIVED

If well telescopes please sketch and show depths.

GROUND LEVEL

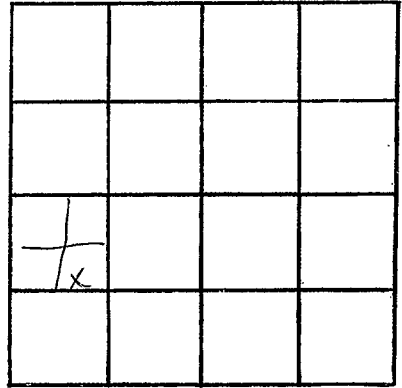

SECTION 36

Please indicate well location X.

ADDITIONAL INFORMATION

If more than one screen,  
show locations of each on sketch.