

MISSISSIPPI DEPARTMENT OF NATURAL RESOURCES

Bureau of Land and Water Resources

Southport Mall

P.O. Box 10631

Jackson, Mississippi 39209

WATER WELL DRILLERS LOG

PEARL RIVER

B 2011

4/19
date well completed

8th Bud Penton Waterwell Pearl River
19 firm name county well located

LANDOWNER: <u>Mat Burge</u>	description of formations encountered	from	to
<u>PO Box 606</u>			
<u>Poplarville Miss.</u> (mailing address)	<u>Red sand</u>	<u>30</u>	<u>60</u>
	<u>White shale</u>	<u>60</u>	<u>150</u>
	<u>White sand & rock</u>	<u>60</u>	<u>192</u>

WELL LOCATION:
 sec. 12 T-1 N R-16 E
 (S) (W)
14 miles N of Poplarville
 (distance) (direction) (nearest town)

WELL PURPOSE: Home
 (home, irrigation, municipal, industrial)

- WELL COMPLETION DATA:
- (1) diameter (inches) 4"
 - (2) total depth (feet) 192
 - (3) static water level (feet) 70 below above top of ground.
 - (4) casing PVC, 182,
 (material) (depth)
 _____ If telescope see back.
 (size)
 - (5) screen 4x10, 182
 (length) (depth to top)
12, PVC
 (size) (material)
 - (6) pump 1 1350
 (HP) (yield gpm)
Elec
 (type power)
 - (7) electric log no
 (yes or no)

 (organization running log)

(8) how well bottom plugged sand
Shark

DRILLERS REMARKS:


DEPT. OF NATURAL RESOURCES
 BUREAU OF LAND & WATER RESOURCES

JUL 19 1984

RECEIVED

If well telescopes please sketch and show depths.

GROUND LEVEL

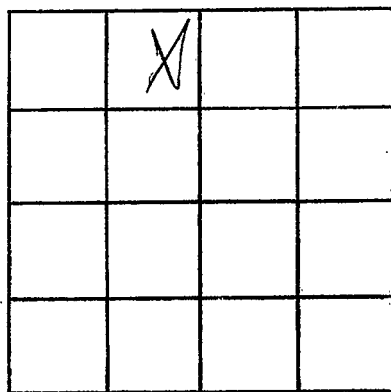

SECTION _____

Please indicate well location X.

ADDITIONAL INFORMATION

If more than one screen,
show locations of each on sketch.