

MISSISSIPPI DEPARTMENT OF NATURAL RESOURCES

Bureau of Land and Water Resources

Southport Mall

P.O. Box 10631

Jackson, Mississippi 39209

WATER WELL DRILLERS LOG

P. River
B 2012

5/24 1988 Red Pentonson Pearl River
date well completed firm name county well located

LANDOWNER: David Burrus
R.T. Box 38E
Poplarville 39470
(mailing address)


description of formations encountered	from	to
<u>Red shale</u>	<u>0</u>	<u>21</u>
<u>Red sand</u>	<u>21</u>	<u>35</u>
<u>Blue shaley</u>	<u>35</u>	<u>420</u>
<u>Gray sand</u>	<u>420</u>	<u>65</u>

WELL LOCATION:
sec 36 T 1 N R 16 E
8 miles NE of Poplarville
(distance) (direction) (nearest town)

WELL PURPOSE: home
(home, irrigation, municipal, industrial)

WELL COMPLETION DATA:

- (1) diameter (inches) 4" x 2"
- (2) total depth (feet) 505
- (3) static water level (feet) 169 below above top of ground.
- (4) casing PVC 495
(material) (depth)
7x2 if telescope see back.
(size)
- (5) screen 10 495
(length) (depth to top)
12 PVC
(size) (material)
- (6) pump 2 18
(HP) (yield gpm)
Electr
(type power)
- (7) electric log no
(yes or no)
(organization running log)
- (8) how well bottom plugged Sand
Shark

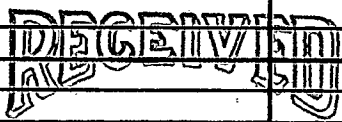


JUN 16 1988

Department of Natural Resources
Bureau of Land & Water Resources

DRILLERS REMARKS:

If well telescopes please sketch and show depths.

GROUND LEVEL

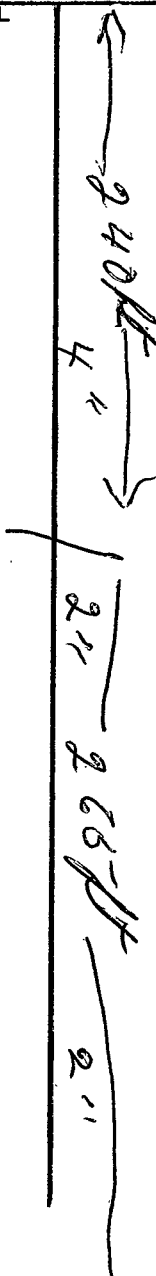

	X		

SECTION _____

Please indicate well location X.

ADDITIONAL INFORMATION

If more than one screen, show locations of each on sketch.