

MISSISSIPPI DEPARTMENT OF NATURAL RESOURCES

Bureau of Land and Water Resources

Southport Mall

P.O. Box 10631

Jackson, Mississippi 39209

WATER WELL DRILLERS LOG

P. RIVER  
B 2013

Sept 19 19 19  
date well completed

Clear Water Drilling Co. Pearl River  
firm name county well located

LANDOWNER: Teal Sampson  
Spring Hill Rd.  
Poplarville MS 39470  
(mailing address)

WELL LOCATION:  
sec. 8 T. 1 N. R. 16 E.  
(S) (W)  
9 miles NW of Poplarville  
(distance) (direction) (nearest town)

WELL PURPOSE: Home  
(home, irrigation, municipal, industrial)

WELL COMPLETION DATA:

- (1) diameter (inches) 9"
- (2) total depth (feet) 320'
- (3) static water level (feet) 96' below above top of ground.
- (4) casing PVC, 310'  
(material) (depth)  
(size) if telescope see back.
- (5) screen 10, 310'  
(length) (depth to top)  
010, PVC Slot  
(size) (material)
- (6) pump 1/2, 1 1/2  
(HP) (yield gpm)  
220V  
(type power)
- (7) electric log (yes or no) \_\_\_\_\_  
(organization running log) \_\_\_\_\_
- (8) how well bottom plugged SS

description of formations encountered	from	to
<u>top soil</u>	<u>0</u>	<u>3</u>
<u>yellow clay</u>	<u>3</u>	<u>10'</u>
<u>Red L yellow clay</u>	<u>10</u>	<u>18'</u>
<u>Red, tan yellow clay</u>	<u>18</u>	<u>30'</u>
<u>med to coarse tan sand</u>	<u>30</u>	<u>65'</u>
<u>Blue clay</u>	<u>65</u>	<u>290</u>
<u>med to coarse tan sand</u>	<u>290</u>	<u>320</u>


RECEIVED  
FEB 10 1981

Department of Natural Resources  
Bureau of Land & Water Resources

DRILLERS REMARKS:

If well telescopes please sketch and show depths.

GROUND LEVEL

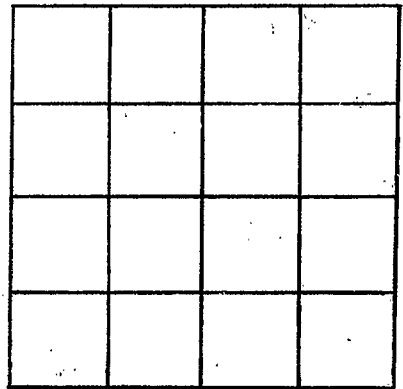

SECTION \_\_\_\_\_

Please indicate well location X.

ADDITIONAL INFORMATION

If more than one screen, show locations of each on sketch.