

MISSISSIPPI DEPARTMENT OF NATURAL RESOURCES

Bureau of Land and Water Resources

Southport Mall

P.O. Box 10631

Jackson, Mississippi 39209

WATER WELL DRILLERS LOG

P. Over
B 2015

12/30 1988 Bud Pentecost Pearl River
date well completed firm name county well located


LANDOWNER: Leslie Roice
R.T. 2 Box 18
poplar miss
(mailing address)

description of formations encountered	from	to
Red shale	0	13
Red sand	13	45

WELL LOCATION:
sec. 24 T. 2 N R. 11 E
1 miles NW Poplar
(distance) (direction) (nearest town)

WELL PURPOSE: home
(home, irrigation, municipal, industrial)

- WELL COMPLETION DATA:
- (1) diameter (inches) 1 1/2"
 - (2) total depth (feet) 45
 - (3) static water level (feet) 33 below above top of ground.
 - (4) casing PVC 35 (material) (depth) (size) if telescope see back.
 - (5) screen 10 35 (length) (depth to top) (size) (material)
 - (6) pump 1/2 15 (HP) (yield gpm) (type power) Elect
 - (7) electric log NO (yes or no)
(organization running log)
 - (8) how well bottom plugged Sand

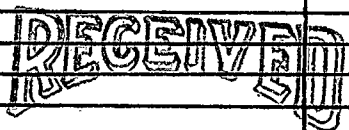


MAR 27 1989

Department of Natural Resources
Bureau of Land & Water Resources

DRILLERS REMARKS:

If well telescopes please sketch and show depths.

GROUND LEVEL

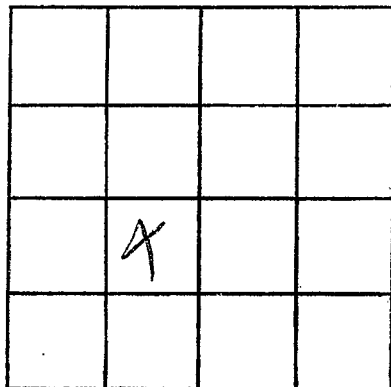

SECTION _____

Please indicate well location X.

ADDITIONAL INFORMATION

If more than one screen,
show locations of each on sketch.