

MISSISSIPPI DEPARTMENT OF ENVIRONMENTAL QUALITY
Office of Land and Water Resources

P. O. Box 10631
Jackson, MS 39289-0631
WATER WELL DRILLERS LOG

COUNTY WELL LOCATED
Pearl River

WELL NUMBER CODED
B-2024

DATE WELL COMPLETED
1-18-01

PERMIT NUMBER

NAME OF DRILLING FIRM
Bones Waterwell

NAME & MAILING ADDRESS OF LANDOWNER
Harry Lee

586 Stanford Lake Rd
Poplarville, ms 39470

WELL LOCATION: SEC 28 TOWNSHIP 1 N RANGE 16 E

DISTANCE 10 Miles DIRECTION NW of NEAREST TOWN Poplarville

OTHER LANDMARK

WELL PURPOSE: Home, Irrigation, Municipal, Industrial, Fish Pond, etc.

PUMP DATA

PUMP TYPE (Circle One):
 Submersible, Turbine, Jet, Flowing Well,
Other (Describe) _____

POWER TYPE (Circle One):
 Electric, Tractor, Diesel, Gasoline, Butane,
Other (Describe) _____ H/P 1

Pump Capacity (GPM) 20 No. of Stages _____ Setting Depth _____ FT.

PUMP TEST

Well yielded _____ GPM with
a drawdown of _____ ft.
after _____ hours of pumping

WELL DATA

Well Depth <u>300</u>	Casing Diameter (In.) <u>4</u>	Casing Length (Ft.) <u>280</u>
Type of Casing <u>sch40</u>	Hole Depth <u>300</u>	Depth to Static Water Level <u>110</u>

TYPE OF COMPLETION: (Circle One or More):
 Gravel Packed, Underreamed, Telescoped,
 Natural Development, Open Hole, Other
(Describe) _____

LOG DATA

TYPE OF LOG RUN (Circle One): No Log Run, Electric, Gamma Ray, Density, Sonic, Neutron,
Other (Describe) _____

Name of Organization Running Log

WELL GROUTED TO A DEPTH OF 10 FEET
Type Grout (circle one): Cement, Bentonite, or Mix

GEOLOGIC DATA (Office Use Only)

Surface Elev.	Geologic Unit	Unit Thickness	Depth to Top
Subs. SWL	Date	Analysis	Aquifer Test

Driller's Remarks

Top of Lap Pipe or Reduction in Casing

FEET IF TELESCOPED OR MORE THAN ONE SCREEN: USE BACK PAGE

SCREEN DATA

Diameter - Inches <u>4</u>	Length - Feet <u>20</u>	Slot Size - Inches <u>#8</u>
Screen Type <u>sch40</u>	Depth to Bottom - Feet	

DESCRIPTION OF FORMATIONS ENCOUNTERED	FROM	TO
<u>Sand</u>	<u>0</u>	<u>40</u>
<u>Clay</u>	<u>40</u>	<u>265</u>
<u>Sand</u>	<u>265</u>	<u>30</u>


FORMATIONS (Continued)	FROM	TO

REC'D AUG 24 2001

IF MORE SPACE IS NEEDED, USE BACK

If well telescopes please
sketch and show depths.

GROUND LEVEL

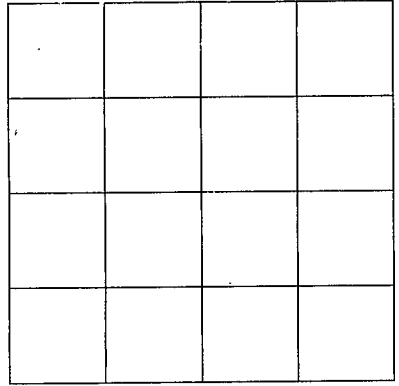

SECTION _____

Please indicate well location X.

ADDITIONAL INFORMATION

If more than one screen,
show location of each on sketch.