

135

CODED

Pearl River  
C1  
9-20-68

MISSISSIPPI  
BOARD OF WATER COMMISSIONERS  
416 North State Street  
Jackson, Mississippi 39201

WATER WELL DRILLERS LOG

Sept 20 1968 Pearl River  
date well completed firm name county well located

LANDOWNER: Johny Tucker  
P.O. #  
Frankston  
(mailing address)

description of formations encountered	from	to
<u>Red clay</u>	<u>0</u>	<u>1</u>
<u>Blue clay</u>	<u>1</u>	<u>12</u>
<u>Clay</u>	<u>12</u>	<u>27</u>
<u>Sand</u>	<u>27</u>	<u>30</u>

WELL LOCATION:  
sec. 6 T. 1 N. R15 E  
5 miles W of Frankston  
(distance) (direction) (nearest town)

WELL PURPOSE: Home  
(home, irrigation, municipal, industrial)

WELL COMPLETION DATA:

(1) diameter (inches) 2"

(2) total depth (feet) 40

(3) static water level (feet) 27 below above top of ground.

(4) casing 1/2" 40' (material) (depth)  
2 if telescope see back. (size)


(5) screen 3' (length) 35' (depth to top)  
1/2" galv. (size) (material)

(6) pump 1/2 HP (HP) 2 (yield gpm)  
(type power)

(7) electric log \_\_\_\_\_ (yes or no)  
(organization running log)

(8) how well bottom plugged None


CODED

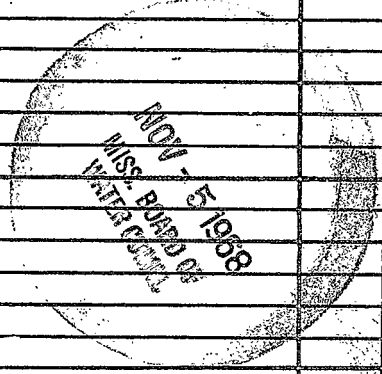

DRILLERS REMARKS:

If well telescopes please sketch and show depths.

GROUND LEVEL

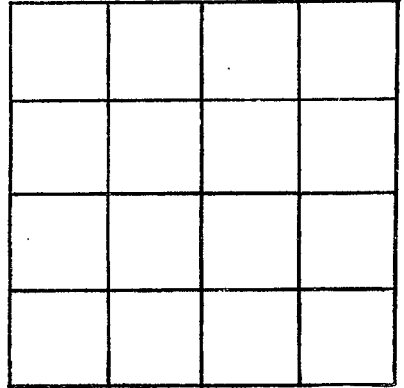

SECTION 6

Please indicate well location X.

ADDITIONAL INFORMATION

If more than one screen, show locations of each on sketch.