

Pearl River
C.3
2-26-69

MISSISSIPPI
BOARD OF WATER COMMISSIONERS CODED
416 North State Street
Jackson, Mississippi 39201

WATER WELL DRILLERS LOG CODED

1969 date well completed Pearl River county well located
1969 Leaden Pearl River firm name

LANDOWNER: King Amos
O. Rank

description of formations encountered	from	to
hard sand	0	2
dark sand	2	20
dark sand	20	70
white sand	70	100
dark sand	100	120
white sand	120	165
dark	165	220

323 Lumberton, Miss.
(mailing address)

WELL LOCATION:
sec. 36 T. 1 N. R. 15 E.
S. 1 S. W. 1 S
5.1 miles S of Lumberton
(distance) (direction) (nearest town)

WELL PURPOSE: Water
(home, irrigation, municipal, industrial)

WELL COMPLETION DATA:


- (1) diameter (inches) 4
- (2) total depth (feet) 220
- (3) static water level (feet) 132 below top of ground.
- (4) casing PVC 210 (material), (depth)
4 (size) if telescope see back.
- (5) screen 10 210 (length), (depth to top)
4 (size), PVC (material)
- (6) pump 1 20 (HP), (yield gpm)
elec. (type power)
- (7) electric log no (yes or no)
- (organization running log)
- (8) how well bottom plugged Badly 6.4

CODED
FEB 27 1969
MISS. Bd. of WATER COMMISSIONERS

DRILLERS REMARKS:

If well telescopes please sketch and show depths.

GROUND LEVEL

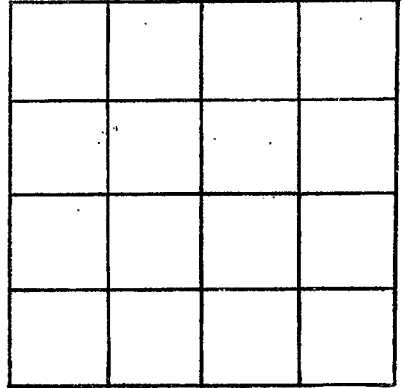

SECTION

36

Please indicate well location X.

ADDITIONAL INFORMATION

If more than one screen, show locations of each on sketch.