

Pearl River
 C 5
 4-12-69

MISSISSIPPI
 BOARD OF WATER COMMISSIONERS
 416 North State Street
 Jackson, Mississippi 39201

WATER WELL DRILLERS LOG

CODED

4-12-69 1969 Pearl River
 date well completed firm name county well located

LANDOWNER:
 Boyd Howard
 Rt. Poplarville Miss
 (mailing address)

description of formations encountered	from	to
Shinarump	0	1
Clay	1	21
Sand	21	41

WELL LOCATION:
 sec. 7 T N R E
 S W
 7 1/2 miles SW of Poplarville
 (distance) (direction) (nearest town)

WELL PURPOSE: irrigation
 (home, irrigation, municipal, industrial)

- WELL COMPLETION DATA:
- (1) diameter (inches) 2 1/2
 - (2) total depth (feet) 46
 - (3) static water level (feet) 38 below above top of ground.
 - (4) casing PRC 41
 (material) (depth)
2 if telescope see back.
 (size)
 - (5) screen 5' 41
 (length) (depth to top)
012 PRC
 (size) (material)
 - (6) pump 1/2 7
 (HP) (yield gpm)
Star
 (type power)
 - (7) electric log N/O
 (yes or no)

CODED

(organization running log)
 (8) how well bottom plugged 3m valve


DRILLERS REMARKS:

APR 17 1969

MISS. BD. OF
 WATER COMM.

If well telescopes please sketch and show depths.

GROUND LEVEL

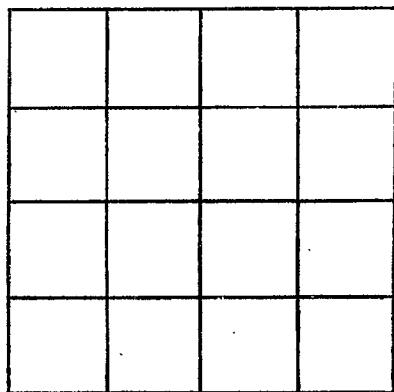

SECTION 7

Please indicate well location X.

ADDITIONAL INFORMATION

If more than one screen, show locations of each on sketch.