

*Paul R. ...*  
*C 6*  
*6-2-69*

MISSISSIPPI  
 BOARD OF WATER COMMISSIONERS  
 416 North State Street  
 Jackson, Mississippi 39201

CODED

WATER WELL DRILLERS LOG

date well completed 19 *6-2-69*

firm name *Paul R. ...*

county well located *Paul R. ...*

LANDOWNER: *Paul R. ...*

description of formations encountered

from

to

(mailing address)

WELL LOCATION:

sec 1 T S N 15 R W E  
 (distance) miles (direction) of (nearest town)

WELL PURPOSE: *...*  
 (home, irrigation, municipal, industrial)

WELL COMPLETION DATA:

- (1) diameter (inches) 7 1/2
- (2) total depth (feet) 40
- (3) static water level (feet) 30 below above top of ground.
- (4) casing PC 3 1/2 (material) (depth)  
2 (size) if telescope see back.
- (5) screen 5' 25' (length) (depth to top)  
0 1/2 (size) PC (material)
- (6) pump 1/2 (HP) 8 (yield gpm)  
... (type power)
- (7) electric log NO (yes or no)

(organization running log)

(8) how well bottom plugged *BN Kelly*

*JUN 29 1969*


DRILLERS REMARKS:

*Drill bits used  
 ...*

MISS. Bd. of  
 WATER COM. L.

If well telescopes please sketch and show depths.

GROUND LEVEL

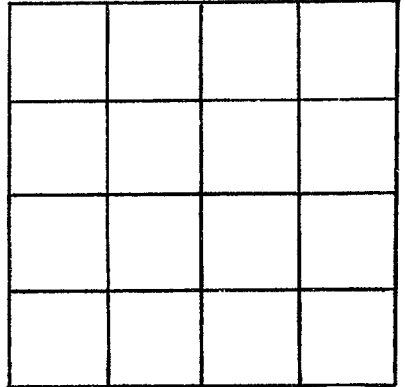

SECTION \_\_\_\_\_

Please indicate well location X.

ADDITIONAL INFORMATION

If more than one screen, show locations of each on sketch.