

Deare River
 C7
 S-15-69

MISSISSIPPI
 BOARD OF WATER COMMISSIONERS
 416 North State Street
 Jackson, Mississippi 39201

CODED

WATER WELL DRILLERS LOG

5-15-69 date well completed
 Leo Lubet firm name
 Pearl River county well located

LANDOWNER: Herbert Knight
 RT
 Poplarville Miss
 (mailing address)

description of formations encountered	from	to
Top Soil	0	1
Red clay	1	2
Red shale	2	4

WELL LOCATION:
 sec 32 T 1 N R 15 E
6 miles N of Poplarville
 (distance) (direction) (nearest town)

WELL PURPOSE: Normal
 (home, irrigation, municipal, industrial)

- WELL COMPLETION DATA:
- (1) diameter (inches) 2
 - (2) total depth (feet) 42
 - (3) static water level (feet) 32 below above top of ground.
 - (4) casing PRC 40
 (material) (depth)
2' If telescope see back.
 (size)
 - (5) screen 5 40
 (length) (depth to top)
012 PRC
 (size) (material)
 - (6) pump 1 10
 (HP) (yield gpm)
PRC
 (type power)
 - (7) electric log NO
 (yes or no)
 (organization running log)

(8) how well bottom plugged BWT


DRILLERS REMARKS:

JUN 9 - 1969

MISS. BD. OF
 WATER COMM.

If well telescopes please sketch and show depths.

GROUND LEVEL

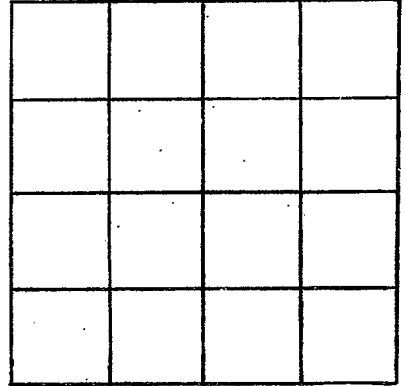

SECTION 32

Please indicate well location X.

ADDITIONAL INFORMATION

If more than one screen, show locations of each on sketch.