

Pearl River  
C9  
1-70

MISSISSIPPI  
BOARD OF WATER COMMISSIONERS  
416 North State Street  
Jackson, Mississippi 39201

CODED

WATER WELL DRILLERS LOG

JAN. 1970 E.B. SHEPARD PEARL RIVER  
date well completed firm name county well located

LANDOWNER:  
L. C. HOWARD  
RE. 4 - LUMBERTON  
(mailing address)

description of formations encountered	from	to
SAND & GRAVEL	0	48
HARD BLUE GRAY SAND & GRAVEL	48	210
SAND & GRAVEL	210	244

WELL LOCATION:  
sec 33 T. 10 N. R. 15 E.  
2 miles W of LUMBERTON  
(distance) (direction) (nearest town)

WELL PURPOSE:  
(home) irrigation, municipal, industrial

WELL COMPLETION DATA:

(1) diameter (inches) 2"  
(2) total depth (feet) 244  
(3) static water level (feet) 124 (below) above top of ground.  
(4) casing PL. 244 (material) (depth)  
2" if telescope see back. (size)  
(5) screen 3' (length) (depth to top)  
2 1/2" S.S. (size) (material)  
(6) pump 1 1/2 (HP) 7 (yield gpm)  
E (type power)  
(7) electric log (yes or no) (yes or no)  
(organization running log)  
(8) how well bottom plugged BWL

CODED


MAR 17 1970

MISS. BD. OF  
WATER COM.

DRILLERS REMARKS:

If well telescopes please sketch and show depths.

GROUND LEVEL

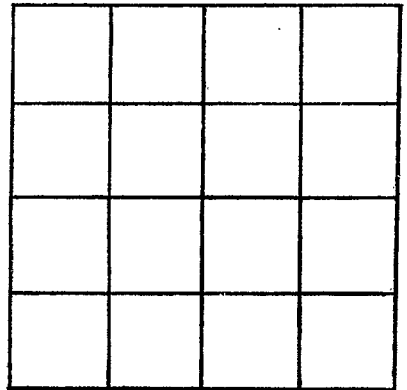

SECTION \_\_\_\_\_

Please indicate well location X.

ADDITIONAL INFORMATION

If more than one screen, show locations of each on sketch.