

PEARL RIVER
C12
5-26-71

MISSISSIPPI
BOARD OF WATER COMMISSIONERS
416 North State Street
Jackson, Mississippi 39201

CODED

WATER WELL DRILLERS LOG

Service
Pearl River

May 26 1971 Easley Stafford Water Well
date well completed Well name county well located

LANDOWNER: Earl Masaner

description of formations encountered

from

to

Route 1, Box 53 B

Poplarville, Miss
(mailing address)

Clay

0

15

WELL LOCATION:

sec. 31 T 1 S R 15 W
5 miles North of Poplarville
(distance) (direction) (nearest town)

Chalk

15

80

Sand & Gravel

80

160

WELL PURPOSE:

(home, irrigation, municipal, industrial)

WELL COMPLETION DATA:

- (1) diameter (inches) 4 in
- (2) total depth (feet) 160
- (3) static water level (feet) 80 ft below top of ground.
- (4) casing Plastic 150 (material) (depth)
4 in (size) if telescope see back.
- (5) screen 10 150 (length) (depth to top)
4 in Plastic (size) (material)
- (6) pump 1/2 900 (HP) (yield gpm/h)
Elec (type power)
- (7) electric log (yes or no)

CODED

JUN 10 1971

(organization running log)

- (8) how well bottom plugged B.W.V.


MISS. BD. OF
WATER COMM.

DRILLERS REMARKS:

Charles Stafford

If well telescopes please sketch and show depths.

GROUND LEVEL

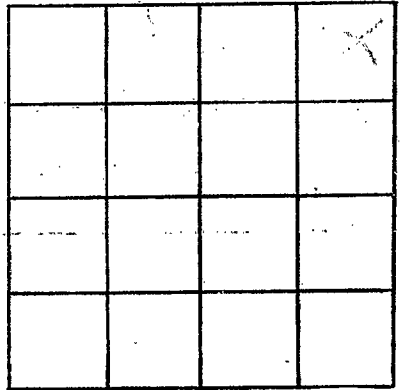

SECTION _____

Please indicate well location X.

ADDITIONAL INFORMATION

If more than one screen, show locations of each on sketch.