

MISSISSIPPI BOARD OF WATER COMMISSIONERS

Pearl R.

C-13

1-14-61

WATER WELL DRILLERS LOG

CODED

Date: Jan 14, 19 61, Driller: Leo Salner 2358 (Name) County: Franklin

(1) Owner of Land: CM Burgo (Name)

Lumberton (Address)

(2) Location: 1/4, 1/4, Sec. 7 T 1 R 15

5 miles SW of Lumberton (distance) (direction) (Nearest Town)

(3) Topography: (Hilly) (Flat) (Level)

(4) Purpose of Well: Domestic (Domestic Irrigation Municipal, Industrial, Other)

Description & Color of Materials Sand, Clay, Red Clay, Shell, etc.	Thick-ness Feet	Depth Feet
<u>Sand Clay</u>	<u>16</u>	<u>0-16</u>
<u>Clay</u>	<u>159</u>	<u>16-175</u>
<u>Sand</u>	<u>25</u>	<u>175-200</u>

CODED

Information upon completion of well:

(1) Diameter 2 inches.

(2) Total Depth 200 feet.

(3) Water Level 90 feet below top of ground.

(4) Cased to 195, Size 2"

(5) Screen: Size 008, Length 5ft


(6) Were any formations sealed against pollution?

yes, no.

If YES depth of formation _____

Why _____

Drillers Remarks: _____

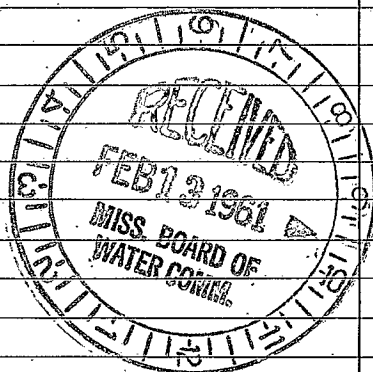

26

Well No.

(Use Back Side)

