

C-14  
3-3-61

WATER WELL DRILLERS LOG

C-308

Date: Mar 3, 1961, Driller: Les Sabes County: Pearl River

(Name)

(1) Owner of Land: <u>Wood Hunt</u> (Name) <u>Summit Main</u> (Address)	Description & Color of <u>Clay</u> Sand, Clay, Red Clay, Shell, etc. <u>Sand</u>	CODED 35 0-25 2 25-37 68 37-95 32 95-117 3 117-120 44 120-144	Depth Feet
(3) Topography: <u>Flat</u> (Hilly) (Flat) (Level)			
(4) Purpose of Well: <u>Camp</u> (Domestic Irrigation Municipal, Industrial, Other)			


Information upon completion of well:

- (1) Diameter 2 inches.
- (2) Total Depth 164 feet.
- (3) Water Level 54 feet below top of ground.
- (4) Cased to 160, Size 2".
- (5) Screen: Size 008, Length 4'.
- (6) Were any formations sealed against pollution?  
 yes,  no.

If YES depth of formation \_\_\_\_\_

Why \_\_\_\_\_

Drillers Remarks: \_\_\_\_\_

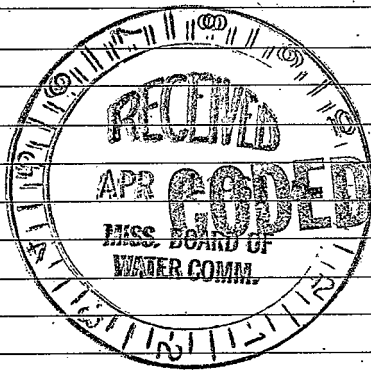

33

Well No.

(Use Back Side)

