

Pearl R,
C-15
6-61

MISSISSIPPI BOARD OF WATER COMMISSIONERS

CODED

WATER WELL DRILLERS LOG

Date: June, 1961, Driller: Leo Salmer County Pearl River
(Name)

(1) Owner of Land: Shirley Stokes
(Name)
Rt Poplarville Miss
(Address)

Description & Color of Materials
Sand, Clay, Red Clay, Shell, etc.

Thick-
ness
Feet

Depth
Feet

Red sandy clay 32 0-32
Red sand 21 32-53

(2) Location: 1/4, 1/4, Sec. 32 T 1 R 5,
6 miles North, of Poplarville
(distance) (direction) (Nearest Town)

(3) Topography: (Hilly) (Flat) (Level)

(4) Purpose of Well: None Use
(Domestic Irrigation
Municipal, Industrial, Other)

Information upon completion of well:

(1) Diameter 4 inches.

(2) Total Depth 53 feet.

(3) Water Level 30 feet below top of ground.

(4) Cased to 53, Size 4"

(5) Screen: Size 1040, Length 5'

(6) Were any formations sealed against pollution?


no

If YES depth of formation _____

Why _____

Drillers Remarks: _____

CODED

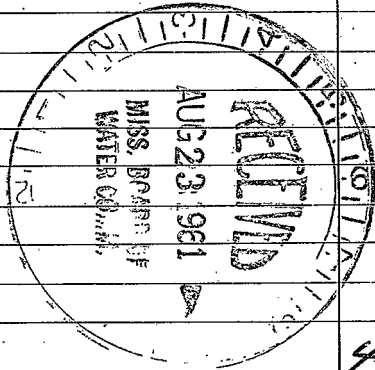

(Use Back Side)

Well No. 46

